


Give All Information Completely
Make Required Affidavit
Mail or Deliver Report to:
Conservation Division
State Corporation Commission
211 No. Broadway
Wichita, Kansas

WELL PLUGGING RECORD

NORTH

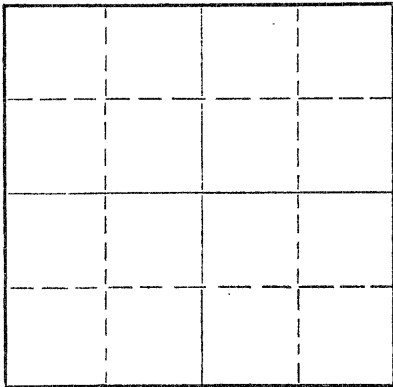

Locate well correctly on above
Section Plat

Rooks County, Sec. 2 Twp. 9 Rge. 17W(E) (W)
Location as "NE/CNW%SW%" or footage from lines SE NE NE
Lease Owner Bennett & Roberts Oil Operations
Lease Name Traynor Well No. 3
Office Address Drawer 633, Russell, Ks.
Character of Well (completed as Oil, Gas or Dry Hole) Dry Hole
Date well completed 8/5/62 19
Application for plugging filed 8/5/62 orally 19
Application for plugging approved 8/5/62 verbally 19
Plugging commenced 8/5/62 19
Plugging completed 8/5/62 19
Reason for abandonment of well or producing formation Dry hole

If a producing well is abandoned, date of last production _____ 19
Was permission obtained from the Conservation Division or its agents before plugging was commenced? Yes

Name of Conservation Agent who supervised plugging of this well Eldon Petty
Producing formation _____ Depth to top _____ Bottom _____ Total Depth of Well 3358 Feet
Show depth and thickness of all water, oil and gas formations.

OIL, GAS OR WATER RECORDS

CASING RECORD

FORMATION	CONTENT	FROM	TO	SIZE	PUT IN	PULLED OUT
				8 5/8"	241'	None

Describe in detail the manner in which the well was plugged, indicating where the mud fluid was placed and the method or methods used in introducing it into the hole. If cement or other plugs were used, state the character of same and depth placed, from _____ feet to _____ feet for each plug set.

Heavy mud to base of surface. Plug @ 235' w/20 sx, Plug @ 160' w/20 sx, Plug @ 35' w/10 sx.

RECEIVED
STATE CORPORATION COMMISSION
SEP 10 1962
CONSERVATION DIVISION
Wichita, Kansas

(If additional description is necessary, use BACK of this sheet)

Name of Plugging Contractor _____
Address _____

STATE OF KANSAS, COUNTY OF RUSSELL, ss.
Donald L. Roberts (employee of owner) or ~~owner or operator~~ of the above-described well, being first duly sworn on oath, says: That I have knowledge of the facts, statements, and matters herein contained and the log of the above-described well as filed and that the same are true and correct. So help me God.

(Signature) Donald L. Roberts
Russell, Kansas
(Address)

SUBSCRIBED AND SWORN TO before me this 6th day of September, 19 62

My commission expires 6/17/66

Clara Hummel
Notary Public.



15-163-02839-0000

Bennett & Roberts Oil Operations
TRAYNOR #3

SE NE NE Section 2-9-17W
Rooks County, Kansas

R.T.D. 3358

CONTRACTOR: Bennett & Roberts Drilling, Inc.

Commenced 8/28/62
Completed 9/5/62

Set 8 5/8" Casing @ 241' w/160 sx cmt.

Post Rock	40'
Clay & Shale	90
Shale	241
Blue Shale	450
Shale & Shells	850
Sand	1030
Red Bed, Shale & Sand	1274
Anhydrite	1814
Shale	1470
Shale & Shells	1760
Shale & Lime	2955
Lime	3060
Lime & Shale	3135
Lime	3858

RECEIVED
STATE CORPORATION COMMISSION

SEP 10 1962

9/10/62

CONSERVATION DIVISION
Topeka, Kansas

STATE OF KANSAS)
RUSSELL COUNTY) SS.

I hereby certify that the above information is correct to the best of my knowledge.

BENNETT & ROBERTS DRILLING, INC.

By [Signature]

Subscribed and sworn to before me this 6th day of September, 1962.

[Signature]
Notary Public

My Commission Expires 6/17/66