


Give All Information Completely
Make Required Affidavit
Mail or Deliver Report to:
Conservation Division
State Corporation Commission
211 No. Broadway
Wichita, Kansas

WELL PLUGGING RECORD

Rooks County. Sec. 3 Twp. 9S Rge. 17 (E) W (W)

Location as "NE/CNW/SW" or footage from lines SW SW SW
Lease Owner D. G. Hansen
Lease Name Thompson "B" Well No. 1
Office Address Logan, Kansas
Character of Well (completed as Oil, Gas or Dry Hole) dry hole
Date well completed August 13 19 62
Application for plugging filed August 13 19 62
Application for plugging approved August 13 19 62
Plugging commenced August 13 19 62
Plugging completed August 13 19 62
Reason for abandonment of well or producing formation Too low structurally

NORTH

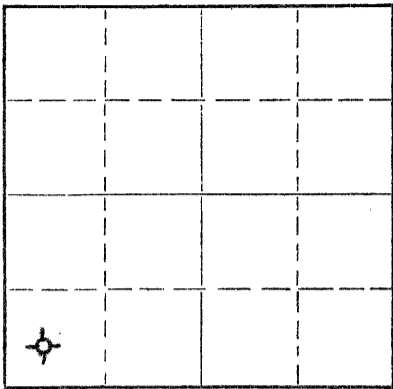

Locate well correctly on above Section Plat

If a producing well is abandoned, date of last production _____ 19____
Was permission obtained from the Conservation Division or its agents before plugging was commenced? yes

Name of Conservation Agent who supervised plugging of this well Eldon Petty, Hays, Kansas
Producing formation _____ Depth to top _____ Bottom _____ Total Depth of Well _____ Feet
Show depth and thickness of all water, oil and gas formations.

OIL, GAS OR WATER RECORDS

CASING RECORD

FORMATION	CONTENT	FROM	TO	SIZE	PUT IN	PULLED OUT
				8-5/8"	190.88'	none

Describe in detail the manner in which the well was plugged, indicating where the mud fluid was placed and the method or methods used in introducing it into the hole. If cement or other plugs were used, state the character of same and depth placed, from _____ feet to _____ feet for each plug set.

Filled hole with heavy mud to 550'. set plug. Filled with mud to 35'. Set plug at 35'. Put in 10 sacks cement, filled to top.
with heavy mud to 180', set plug. Put in 20 sacks cement, filled

8/22/62
RECEIVED
STATE CORPORATION COMMISSION
AUG 22 1962
CONSERVATION DIVISION
Wichita, Kansas

(If additional description is necessary, use BACK of this sheet)

Name of Plugging Contractor _____
Address _____

STATE OF KANSAS, COUNTY OF SEDGWICK, ss. G. F. Galloway (employee of owner) or (~~owner~~) of the above-described well, being first duly sworn on oath, says: That I have knowledge of the facts, statements, and matters herein contained and the log of the above-described well as filed and that the same are true and correct. So help me God.

(Signature) G. F. Galloway
107 Rule Building, Wichita, Ks
(Address)

SUBSCRIBED AND SWORN TO before me this 17 day of August, 19 62

My commission expires May 20, 1963

Vicky Jacobs
Notary Public.



15-163-04044-00-00

WELL LOG

OPERATOR D. G. HANSEN SEC. 3-9-17W
 WELL NAME THOMPSON "B" #1 LOC. SW SW SW
 TOTAL DEPTH 3481' COUNTY ROOKS
 COMM. JULY 31, 1962 COMP. AUGUST 13, 1962 STATE KANSAS
 RIG NO. 1 ELEVATION 2034' KB
 CASING: Ran 190.88' (9 jts.) 8-5/8" OD Surface Casing PRODUCTION: D & A

All measurements taken from the top of rotary bushing.

FROM	TO	FORMATION	DEVIATION FROM VERTICAL	REMARKS:
0	680	Shale & Sand	0° - 190'	
680	800	Sand & Shale		
800	1050	Sand	1 1/2° - 1000'	
1050	1362	Shale-Red Bed	2° - 1190'	
1364	1447	Anhydrite	2-3/4° - 1438'	
1447	1455	Shale		
1455	1500	Shale-Shells	2 1/2° - 1510	
1500	1800	Shale-Shell	2° - 1573	
1800	1920	Shale-Lime	2° - 1825	
1920	2400	Lime-Shale	1 1/2° - 2040	
2400	2510	Shale-Lime	3/4° - 2295'	
2510	2670	Lime-Shale	1° - 2630'	
2670	2855	Shale-Lime		
2855	3228	Lime-Shale		
3228	3295	Lime	1 1/4° - 3295'	DST #1 3224-3282'
3295	3355	Lime-Shale		
3355	3400	Lime		
3400	3468	Lime-Shale-Chert		
3468	3481	Lime-Shale		DST #2 3476-3481'

RECEIVED
 STATE CORPORATION COMMISSION
 AUG 22 1962

8/22/62

REGISTRATION DIVISION

STATE OF KANSAS)
) SS.
 COUNTY OF SEDGWICK)

The undersigned hereby certifies that to the best of his knowledge and belief, the above facts are true and correct.

C-G DRILLING CO.

By G. F. Galloway

SUBSCRIBED AND SWORN TO, BEFORE ME, THIS 17 day of August, 1962.

My commission expires: May 20, 1963

Vicky Jacobs
Vicky Jacobs - Notary Public