

STATE OF KANSAS  
STATE CORPORATION COMMISSION


WELL PLUGGING RECORD

15-163-20664-00-00

Give All Information Completely  
Make Required Affidavit  
Mail or Deliver Report to  
Conservation Division  
State Corporation Comm.  
245 North Water  
Wichita, KS 67202

Rooks County, Sec. 4 Twp. 9S Rge. 17W E/W  
Location as "NE/CNW $\frac{1}{4}$ /SW $\frac{1}{4}$ " or footage from lines E/2 NW SE

Lease Owner PICKRELL DRILLING COMPANY  
Lease Name TWIN MOUNDS UNIT "D" Well No. 4  
Office Address 205 LITWIN BLDG. WICHITA, KS. 67202  
Character of Well (Completed as Oil, Gas or Dry Hole)

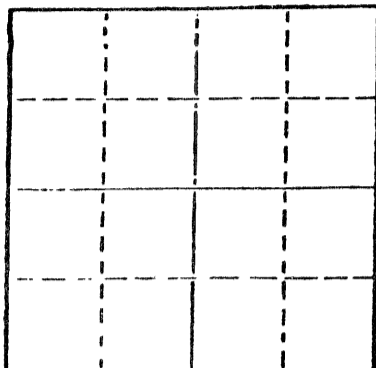

Locate well correctly on above  
Section Plat

Dry Hole  
Date Well completed 12-17-76 19  
Application for plugging filed 12-17-76 19  
Application for plugging approved 12-17-76 19  
Plugging commenced 12-17-76 19  
Plugging completed 12-17-76 19  
Reason for abandonment of well or producing formation  
Dry Hole

If a producing well is abandoned, date of last production 19

Was permission obtained from the Conservation Division or its agents before plugging was commenced? Yes

Name of Conservation Agent who supervised plugging of this well Leo Massey  
Producing formation \_\_\_\_\_ Depth to top \_\_\_\_\_ Bottom \_\_\_\_\_ Total Depth of Well 3557  
Show depth and thickness of all water, oil and gas formations.

OIL, GAS OR WATER RECORDS

CASING RECORD

FORMATION	CONTENT	FROM	TO	SIZE	PUT IN	PULLED OUT
				8 5/8	235	None

Describe in detail the manner in which the well was plugged, indicating where the mud fluid was placed and the method or methods used in introducing it into the hold. If cement or other plugs were used, state the character of same and depth placed, from \_\_\_\_\_ feet to \_\_\_\_\_ feet for each plug set.

50 sxs. at 550'  
25 sxs. at 225'  
10 sacks at 40'

RECEIVED  
STATE CORPORATION COMMISSION

JAN 07 1977 1/7/77

CONSERVATION DIVISION  
Wichita, Kansas

(If additional description is necessary, use BACK of this sheet)

Name of Plugging Contractor PICKRELL DRILLING COMPANY

STATE OF Kansas COUNTY OF Sedgwick, ss.  
C. W. Sebitts (employee of owner) or (owner or operator)

of the above-described well, being first duly sworn on oath, says: That I have knowledge of the facts, statements, and matters herein contained and the log of the above-described well as filed and that the same are true and correct. So help me God.

(Signature)

*C. W. Sebitts*  
205 Litwin Bldg. Wichita, Ks. 67202  
(Address)

SUBSCRIBED AND SWORN TO before me this 28 day of December, 1976

My commission expires \_\_\_\_\_

Jo Ann Sarver

Notary Public.



15-163-2064-00-05

**ROTARY DRILLING LOG**

COMPANY: PICKRELL DRILLING COMPANY  
205 LITWIN BLDG.  
WICHITA, KS. 67202  
LOCATION: TWIN MOUNDS UNIT "D" #4  
E/2 NW SE 4-9S-17W  
Rooks Co., Ks.  
CONTRACTOR: **PICKRELL DRILLING COMPANY**  
**Wichita, Kansas**

Rotary Drilling Commenced 12-8-76  
Rotary Drilling Completed 12-17-76

CASING RECORD: Surface casing of 8 5/8" set at 235' with 160 sx.

**LOG**

(Figures indicate bottom of formation — measurements from top of rotary bushing.)

Top Soil & Post Rock	75
Shale	237
Shale	700
Shale	1440
Shale	1450
Shale	1478
Shale	1725
Shale	1940
Lime & Shale	2170
Lime & Shale	2330
Lime & Shale	2555
Lime & Shale	2700
Lime & Shale	2875
Lime & Shale	3055
Lime & Shale	3140
Lime & Shale	3230
Lime	3310
Lime	3350
Lime	3355
Lime	3370
Lime	3400
Lime	3443
Lime	3452
Lime	3517
Lime	3540
Lime-RTD	3557

1/7/77  
RECEIVED  
STATE CORPORATION COMMISSION  
JAN 07 1977  
CONSERVATION DIVISION  
Wichita, Kansas

The undersigned, C. W. Sebitts, Attorney-in-Fact for PICKRELL DRILLING COMPANY, hereby certifies in behalf of said Company, that the above is a true and correct log of the formation encountered in drilling the above well as reflected by the Daily Drilling Reports.

**PICKRELL DRILLING COMPANY**  
By [Signature]  
Attorney-in-Fact  
C. W. Sebitts

STATE OF KANSAS }  
COUNTY OF SEDGWICK } ss.:

On this 28 day of December, 19 76, before me the undersigned, a Notary Public, in and for the County and State aforesaid, personally appeared C. W. Sebitts, to me known to be the identical person who subscribed the name of PICKRELL DRILLING COMPANY to the foregoing instrument as its Attorney-in-Fact and acknowledged to me that he executed the same as his free and voluntary act and deed, and as the free and voluntary act and deed of such company, for the uses and purposes therein set forth.

Given under my hand and seal of office the day and year last above written.

My commission expires: \_\_\_\_\_

[Signature]  
Notary Public  
Jo Ann Sarver

