


Give All Information Completely  
Make Required Affidavit  
Mail or Deliver Report to:  
Conservation Division  
State Corporation Commission  
211 No. Broadway  
Wichita, Kansas

15-We 3-19228-00 20

WELL PLUGGING RECORD

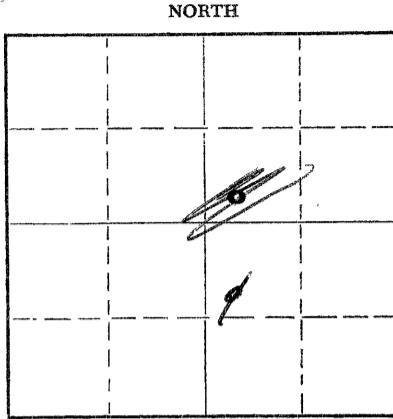

Locate well correctly on above Section Plat

Rooks \_\_\_\_\_ County, Sec. 5 Twp. 9 Rge. 17 (~~XX~~) (W)  
Location as "NE/CNW/SW" or footage from lines SW NW SE  
Lease Owner Murfin Drilling Company  
Lease Name Fike "A" Well No. 3  
Office Address 617 Union Center, Wichita 2, Kansas  
Character of Well (completed as Oil, Gas or Dry Hole) Oil  
Date well completed August 1 19 55  
Application for plugging filed November 10 19 58  
Application for plugging approved November 11 19 58  
Plugging commenced November 13 19 58  
Plugging completed November 22 19 58  
Reason for abandonment of well or producing formation Producing formation ran dry.

If a producing well is abandoned, date of last production November 3 19 58  
Was permission obtained from the Conservation Division or its agents before plugging was commenced? yes

Name of Conservation Agent who supervised plugging of this well Eldon Petty, Hays, Kansas  
Producing formation Lansing-Kansas City Depth to top 3321 Bottom 3415 Total Depth of Well 3461 Feet  
Show depth and thickness of all water, oil and gas formations.

OIL, GAS OR WATER RECORDS

CASING RECORD

FORMATION	CONTENT	FROM	TO	SIZE	PUT IN	PULLED OUT
				8 5/8"	162'	None
				5 1/2"	3450'	2205'

Describe in detail the manner in which the well was plugged, indicating where the mud fluid was placed and the method or methods used in introducing it into the hole. If cement or other plugs were used, state the character of same and depth placed, from \_\_\_\_\_ feet to \_\_\_\_\_ feet for each plug set.

Filed hole with mud and sand to 3100'.  
Pull 5 1/2 to 600'. Circulate 30 sx. gel mud and 20 sx. cement. Pull 5 1/2 to 150'. Pump in 20 sx. cement. Bail mud to 40'. Set 10' rock bridge from 40' to 30'. Mix and dump 10 sxs. cement from 30' to base cellar.

12/18/58  
**RECEIVED**  
STATE CORPORATION COMMISSION  
DEC 18 1958  
CONSERVATION DIVISION  
Wichita, Kansas

(If additional description is necessary, use BACK of this sheet)  
Name of Plugging Contractor Ace Pipe Pulling Company  
Address Box 304, Great Bend, Kansas

STATE OF Kansas, COUNTY OF Sedgwick, ss.  
W. R. Murfin (employee or owner) or (owner or operator) of the above-described well, being first duly sworn on oath, says: That I have knowledge of the facts, statements, and matters herein contained and the log of the above-described well as filed and that the same are true and correct. So help me God.

(Signature) W. R. Murfin  
617 Union Center, Wichita 2, Kansas  
(Address)

SUBSCRIBED AND SWORN TO before me this 16th day of December, 19 58.

My commission expires March 23, 1960  
Donna M. Matzek  
Donna M. Matzek Notary Public.

**PLUGGING**  
FILE SEC 5 T. 9 R. 17W  
BOOK PAGE 144 LINE 31


15-163-19228 - 08-22  
WELL LOG

COMPANY **Murfin Drilling Co.**  
FARM **FIKE "A"** NO. **3**

SEC. **5** T. **9S** R. **17W**  
LOC. **SW NW SE**

TOTAL DEPTH **3461**  
COMM. **6-16-55** rotary cable COMP. **6-27-55**  
SHOT OR TREATED " **8-1-55**  
CONTRACTOR **Murfin Drlg. Co.**  
ISSUED

COUNTY **Rooks**  
**KANSAS**

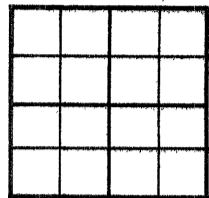

CASING

20 10  
15 8 **162' w/125 sz.**  
12 6  
13 5 **3450' w/75 sz.**

ELEVATION **2013 RB**

PRODUCTION **36 bopd**  
State test **Aug. 22, 1955**

FIGURES INDICATE BOTTOM OF FORMATIONS

Tops:

135 Shale  
535 Shale & Shells  
595 Sand  
700 Shale & Shells  
920 Shale & Sand  
1018 Sand  
1084 Shale & Shells  
1333 Red Bed & Shale  
1370 Anhydrite  
1690 Shale - Shells  
1765 Salt - Shale  
2090 Shale - Lime - Shells  
3266 Shale - Lime  
3275 Lime  
3461 Lime - Shale  
3461 TD (Arb)

Topeka 2900  
Heebner 3120  
Toronto 3139  
LKC 3157  
BKC 3379  
Congl. 3430  
Arbuckle 3447  
RTD 3461

DST #1 3157-99. Open 1 hr.  
Weak blow. Rec. 60' oil  
cut muddy salt Wtr. BHP 0.

DST #2 3212-41. Open 1 hr.  
Rec. 10' mud. BHP 0.

DST #3 3240 - 66. Open 1 hr.  
Rec. 30' mud. BHP 0.

DST #4 3318-38. Open 1 hr.  
Rec. 12' mud. BHP 400#

**PLUGGING**  
FILE SEC 5 T 9 R 17W  
BOOK PAGE 144 LINE 31

State of Kansas }  
County of Sedgwick } SS:

I, W. R. Murfin of the Murfin Drilling Company  
upon oath state that the above and foregoing is a true and correct copy of the log of the Fike "A" #3 well.

Subscribed and sworn to before me this 5th day of August 1955.

My Commission Expires: 6-13-59.

NOTARY PUBLIC