


STATE OF KANSAS  
STATE CORPORATION COMMISSION

Give All Information Completely  
Make Required Affidavit  
Mail or Deliver Report to:  
Conservation Division  
State Corporation Commission  
800 Bitting Building  
Wichita, Kansas

R 15-163-00924-0000  
WELL PLUGGING RECORD

NORTH

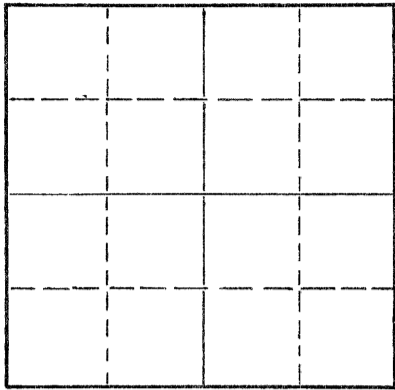

Locate well correctly on above  
Section Plat

Rooks

County. Sec. 6 Twp. 9 Rge. (E) 17 (W)

Location as "NE/CNW/SW" or footage from lines SW SW SW

Lease Owner Herndon Drilling Company

Lease Name Moos Well No. 1

Office Address Drawer 489, Tulsa, Oklahoma

Character of Well (completed as Oil, Gas or Dry Hole) Dry Hole

Date well completed 10-23 19 59

Application for plugging filed 10-23 19 59

Application for plugging approved 10-23 19 59

Plugging commenced 10-23 19 59

Plugging completed 10-23 19 59

Reason for abandonment of well or producing formation

If a producing well is abandoned, date of last production 19

Was permission obtained from the Conservation Division or its agents before plugging was commenced? Yes

Name of Conservation Agent who supervised plugging of this well Eldon Petty, Hays, Kansas

Producing formation Depth to top Bottom Total Depth of Well 3470 Feet

Show depth and thickness of all water, oil and gas formations.

OIL, GAS OR WATER RECORDS

CASING RECORD

FORMATION	CONTENT	FROM	TO	SIZE	PUT IN	PULLED OUT

Describe in detail the manner in which the well was plugged, indicating where the mud fluid was placed and the method or methods used in introducing it into the hole. If cement or other plugs were used, state the character of same and depth placed, from 540 feet to 40 feet for each plug set.

Hole filled with drilling mud to 540 feet--20 sacks mixed and pumped in hole.  
Hole filled to 180 feet with mud--20 sacks mixed and pumped in hole.  
Hole was filled to 40 feet. 10 sacks mixed and pumped in hole.

RECEIVED  
STATE CORPORATION COMMISSION  
JAN 19 1960  
1/19/60  
CONSERVATION DIVISION  
Wichita, Kansas

(If additional description is necessary, use BACK of this sheet)

Name of Plugging Contractor Globe Cementing Company

Address Plainville, Kansas

STATE OF OKLAHOMA, COUNTY OF TULSA, ss.  
Tom Elliott (employee of owner) or (owner or operator) of the above-described

well, being first duly sworn on oath, says: That I have knowledge of the facts, statements, and matters herein contained and the log of the above-described well as filed and that the same are true and correct. So help me God.

(Signature) Tom Elliott

Great Bend, Kansas

(Address)

SUBSCRIBED AND SWORN TO before me this 27th day of October, 19 59

Johnnie Alene Frese  
Johnnie Alene Frese Notary Public.

My commission expires June 19, 1961



15-01163-00924-0020

WELL LOG

Well: HARRY MOOS NO. 1  
Location: SW SW SW, Section 6-9S-17W  
Rooks County, Kansas  
Owner: Herndon Drilling Company

Spudding date: 10-13-59  
Date casing set: 10-13-59  
Date rotary completed: 10-22-59  
Date cable completed:

FROM	TO	FORMATION	REMARKS
0	203	Surface Hole	Ran 5 Joints 8-5/8" Spiral Weld
203	1360	Shale and Shells	22.8#. Set @ 203'. Cemented
1360	1410	Anhydrite	w/150 sacks Common Cement
1410	1600	Shale and Shells	w/2% CC. Cement circulated.
1600	2230	Lime and Shale	
2230	2245	Lime	
2245	2895	Lime and Shale	
2895	3470	Lime	
	3470	Total Depth	Plugged hole w/20 sx. @ 540' 20 sx. @ 180' 10 sx. @ 10'

RECEIVED  
STATE CORPORATION COMMISSION

DEC 10 1964

CONSERVATION DIVISION  
Wichita, Kansas

12/10/64

Subscribed and sworn to before me this 28th  
day of October, 19 59

I certify the above and foregoing to be a true and exact copy  
of the original driller's log on the HARRY MOOS NO. 1

HERNDON DRILLING COMPANY

Johanna Alene Luese  
Notary Public

By: C. T. Moore  
Title: C. T. Moore, Asst. Secty.

My commission expires:

June 19, 1961