

15-163-00769-00.00

STATE OF KANSAS
STATE CORPORATION COMMISSION

Give All Information Completely
Make Required Affidavit
Mail or Deliver Report to:
Conservation Division
State Corporation Commission
211 No. Broadway
Wichita, Kansas

WELL PLUGGING RECORD

Rooks County, Sec. 26 Twp. 9 Rge. 16W (E) (W) X

Location as "NE/CNW%SW%" or footage from lines SW SW NW

Lease Owner Burch Drilling Co., Inc.

Lease Name Reese Well No. 1

Office Address 1011 Union Center, Wichita, Kansas

Character of Well (completed as Oil, Gas or Dry Hole) Dry Hole

Date well completed 8-6-58 19

Application for plugging filed 8-6-58 19

Application for plugging approved 8-6-58 19


Plugging commenced 8-6-58 19

Plugging completed 8-6-58 19

Reason for abandonment of well or producing formation Dry

If a producing well is abandoned, date of last production 19

Was permission obtained from the Conservation Division or its agents before plugging was commenced? yes

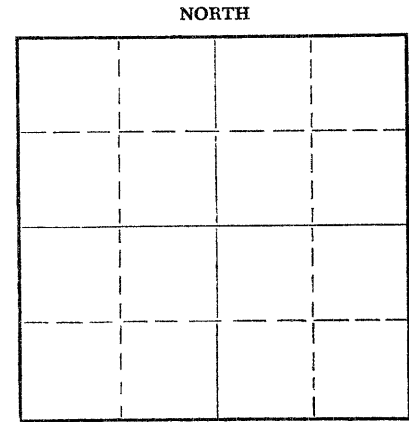

Locate well correctly on above Section Plat

Name of Conservation Agent who supervised plugging of this well Eldon Petty

Producing formation Depth to top Bottom Total Depth of Well 3617' Feet

Show depth and thickness of all water, oil and gas formations.

OIL, GAS OR WATER RECORDS

CASING RECORD

FORMATION	CONTENT	FROM	TO	SIZE	PUT IN	PULLED OUT
				8 5/8"	190'	none

Describe in detail the manner in which the well was plugged, indicating where the mud fluid was placed and the method or methods used in introducing it into the hole. If cement or other plugs were used, state the character of same and depth placed, from feet to feet for each plug set.

Set 1st Plug @ 600' w/25 sx.
 Set 2nd Plug @ 205' w/15 sx.
 Set 3rd Plug @ 40' w/10 sx.

(If additional description is necessary, use BACK of this sheet)

Name of Plugging Contractor Burch Drilling Co., Inc.
Address 1011 Union Center, Wichita, Kansas

STATE OF KANSAS, COUNTY OF SEDGWICK, ss.
Earl M. Burch (employee or owner) or (owner or operator) of the above-described well, being first duly sworn on oath, says: That I have knowledge of the facts, statements, and matters herein contained and the log of the above-described well as filed and that the same are true and correct. So help me God.

(Signature) Earl M. Burch

(Address)

SUBSCRIBED AND SWORN TO before me this 22nd day of August, 19 58

Ginny Harrison Notary Public.

My commission expires July 27, 1960

PLUGGING
FILE SEC. 26 T. 9 R. 16W
BOOK PAGE 122 LINE 33

RECEIVED
STATE CORPORATION COMMISSION
8-23-58
AUG 23 1958

15-163-00769-00-00

WELL LOG

Burch Drilling Co., Inc.
1 Reece
SW SW NW, 26-9-16
Rooks County, Kansas

8 5/8" set at 190' w/135 sx.
ELEVATION: 2042 Kelly Bushing
COMM: 7-29-58
COMP: 8-6-58
D & A

1271 Shale & shells
1302 Anhydrite
1930 Shale & Lime streaks
3075 Lime and Shale
3521 Lime
3592 Lime & Chert
3617 Cherty Lime

3617 RTD

	<u>Tops</u>
Heebner	3154'
Toronto	3177'
Lansing	3198'
BKC	3458'
Conglomerate	3529'
Arbuckle	3596'

DST # 1 3192-3250 Open 1 hr.
Recovered 46' Mud. IBHP (30 Min.)
1200#, IFP 0, FFP 0, FBHP (30)
580#.


DST # 2 Open 1 hr. Recovered
167' Mud plus 70' Salt Water
Cut Mud, IBHP (30Min) 1160#,
IFP 0, FFP 80#, FBHP (30Min.)
900#. The IFP and FFP on this
test are not valid.

STATE OF KANSAS, COUNTY OF SEDGWICK:

I, Earl M. Burch, President of Burch Drilling Co., Inc. being duly sworn on oath,
state: That I have knowledge of the facts, statements and matters herein contained and
that the same are true and correct.



Subscribed and sworn to before me this 22nd day of August, 1958.

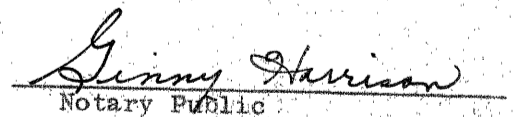
Notary Public

My Commission expires: July 27, 1960

PLUGGING
FILE NO. 26 T. 9. R. 16W
PAGE 122 LINE 33

8-23-58
RECEIVED
STATE CORPORATION COMM

AUG 23 1958

CONSERVATION DIVISION