

STATE OF KANSAS
STATE CORPORATION COMMISSION


15-163-00065-00-00
WELL PLUGGING RECORD

Give All Information Completely
Make Required Affidavit
Mail or Deliver Report to:
Conservation Division
State Corporation Commission
800 Bitting Building
Wichita, Kansas

OR
FORMATION PLUGGING RECORD

Strike out upper line
when reporting plug-
ging off formations.

NORTH

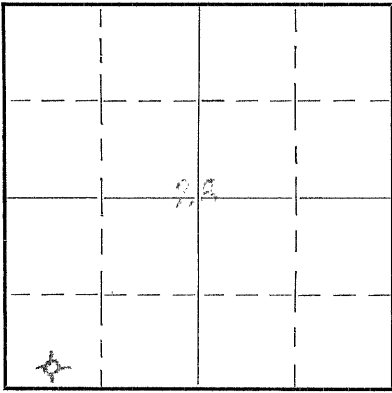

Locate well correctly on above
Section Plat

Rooks County. Sec. 28 Twp. 9 Rge. 16 (E) (W)
Location as "NE $\frac{1}{4}$ NW $\frac{1}{4}$ SW $\frac{1}{4}$ " or footage from lines Center S. Line SW SW
Lease Owner W. L. Hartman
Lease Name Andreson Well No. 1
Office Address Wichita, Kansas, Box 54
Character of Well (Completed as Oil, Gas or Dry Hole) Dry hole
Date, well completed 10-17-42 193
Application for plugging filed 10-18-42 193
Application for plugging approved 10-19-42 193
Plugging Commenced 10-19-42 193
Plugging Completed 10-20-42 193
Reason for abandonment of well or producing formation Dry

If a producing well is abandoned, date of last production 193
Was permission obtained from the Conservation Division or its agents before plugging was com-
menced? Yes

Name of Conservation Agent who supervised plugging of this well C. T. Alexander
Producing formation Depth to top Bottom Total Depth of Well 3426 Feet.

Show depth and thickness of all water, oil and gas formations.


OIL, GAS OR WATER RECORDS

CASING RECORD

Formation	Content	From	To	Size	Put In	Pulled Out
				10"	125	cemented
				7	3097	2700
				5 $\frac{1}{2}$	3345	3345

Describe in detail the manner in which the well was plugged, indicating where the mud fluid was placed and the method or methods used in introducing it into the hole. If cement or other plugs were used, state the character of same and depth placed, from feet to feet for each plug set.

Hole was filled with mud from 3426 to 3365, bridged and cemented to 3345', mudded to 3087, bridged to 3068', mudded to 250', permanent bridge placed and cemented to 230', mudded to 18', cemented to 8' and mudded to top of surface.

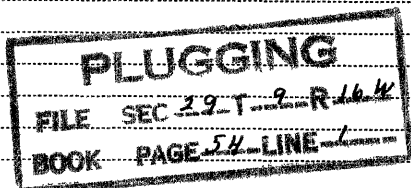

11/25/42

(If additional description is necessary, use BACK of this sheet)

Correspondence regarding this well should be addressed to Address

STATE OF Kansas, COUNTY OF Sedgwich, ss.
I, B. E. Ash (employee of owner) or (owner or operator) of the above-described well, being first duly sworn on oath, says: That I have knowledge of the facts, statements, and matters herein contained and the log of the above-described well as filed and that the same are true and correct. So help me God.

(Signature) B. E. Ash

Plainville, Kansas (Address)

SUBSCRIBED AND SWORN to before me this 26th day of October, 1942.

My commission expires February 5, 1945

Notary Public.

WELL LOG BUREAU - KANSAS GEOLOGICAL SOCIETY
412 Union National Bank Bldg, Wichita, Kansas.


W.L.HARTMAN & THREE WAY DRILG. CO.
Andreson No. 1

SEC. 28 T. 9 R. 16 W.
CSL SW SW

Total Depth. 3426
Comm. 9-4-42 Comp. 10-17-42
Shot or Treated.
Contractor, Three Way Drilling Co.
Issued. 11-7-42

County Rooks.

15-163-00065-00-00

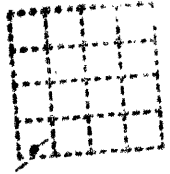

CASING.


10" 125' Cem.
7" 3097'
5 1/2" 3345'

Elevation.

Production. DRY.

Figures Indicate Bottom of Formations.

shale blue	265	lime and shells	3224
shale and shells	575	lime	3232
shale	650	shale	3237
sdv shale	695	lime brokon	3242
sand	798	lime brokon&shale	3252
sdv shale and iron	965	lime	3269
shale	1180	brokon lime	3274
shale and shells	1264	lime	3286
anhydrite	1303	1500 gal acid.	
shale and shells	1600	tosting oil from	3282-86
shale and lime	1630	Swabbing and cleaning	
salt and shells	1722	out. Hole filled up 70' with	
salt and shale	1745	cuttings. After acidizing.	
shale and shells	1784	shale	3285- 96
lime	1825	lime	3303
broken lime	1865	brokon lime	3308
shale and shells	1885	lime	3314
lime and shale	1982	lime hard	3318
broken lime	1995	lime soft	3321 HFW
lime	2000	lime	3243
broken lime	2055	shale	3245
shale and lime	2110	lime	3272
sdv lime	2135	shale	3276
lime	2144	lime	3422
lime broken	2220	sdv lime	3426
lime	2276	Total Dophth.	
lime and red rock	2310		
lime	2360		
lime broken	2447		
shale	2467		
shale and shells	2495		
lime and shale	2565		
shale	2591		
lime	2604		
shale	2624		
shale and shells	2778		
shale	2816		
lime	2854		
lime and shale	2934		
shale and shells	2952		
lime	2970		
shale	2976		
lime	3051		
shale	3063		
lime cherty	3072		
lime	3198.8		
Standardized			
lime	3211		
shale brokon	3214		
shale red & green	3218		

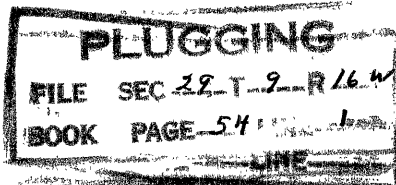

11/25/42