


19-163-02835-00-00

WELL PLUGGING RECORD

Give All Information Completely  
Make Required Affidavit  
Mail or Deliver Report to:  
Conservation Division  
State Corporation Commission  
212 North Market, Insurance Bldg.  
Wichita, Kansas

ROOKS County. Sec. 32 Twp. 9S Rge. 16E (X) (W)  
Location as "NE/CNW/SW" or footage from lines SW NE NE  
Lease Owner PETROLEUM, INC.  
Lease Name COLAHAN "B" Well No. 2  
Office Address ROUTE #2, GREAT BEND, KANSAS  
Character of Well (completed as Oil, Gas or Dry Hole) DRY HOLE  
Date well completed APRIL 27, 19 61  
Application for plugging filed APRIL 27, 19 61  
Application for plugging approved APRIL 27, 19 61  
Plugging commenced APRIL 27, 19 61  
Plugging completed APRIL 27, 19 61  
Reason for abandonment of well or producing formation NO PRODUCIBLE ZONES

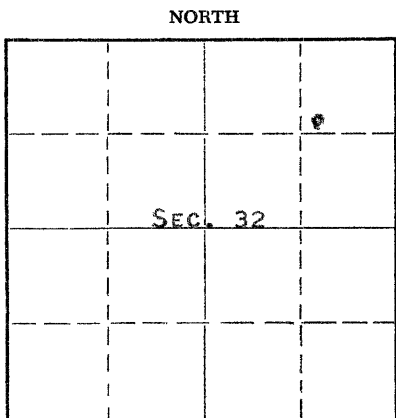

Locate well correctly on above Section Plat

If a producing well is abandoned, date of last production NONE 19  
Was permission obtained from the Conservation Division or its agents before plugging was commenced? YES

Name of Conservation Agent who supervised plugging of this well MR. ELDON PETTY  
Producing formation \_\_\_\_\_ Depth to top \_\_\_\_\_ Bottom \_\_\_\_\_ Total Depth of Well 3505' Feet  
Show depth and thickness of all water, oil and gas formations.

OIL, GAS OR WATER RECORDS

CASING RECORD

FORMATION	CONTENT	FROM	TO	SIZE	PUT IN	PULLED OUT
		NO SURFACE CASING SET				

Describe in detail the manner in which the well was plugged, indicating where the mud fluid was placed and the method or methods used in introducing it into the hole. If cement or other plugs were used, state the character of same and depth placed, from \_\_\_\_\_ feet to \_\_\_\_\_ feet for each plug set.

MUDDED UP WITH HEAVY MUD TO 500', FOLLOWED BY WOODEN PLUG. PLACED 25 SACKS CEMENT THROUGH DRILL PIPE ON TO PLUG. MUDDED UP WITH HEAVY MUD TO 180', FOLLOWED BY WOODEN PLUG. PLACED 25 SACKS CEMENT THROUGH DRILL PIPE ON TO PLUG. MUDDED UP WITH HEAVY MUD TO 25', FOLLOWED BY WOODEN PLUG, HULLS AND 25 SACKS CEMENT TO BASE OF WELL CELLAR. PLACED 2 SACKS CEMENT IN RAT HOLE.

RECEIVED  
STATE CORPORATION COMMISSION

MAY 8 1961

CONSERVATION DIVISION  
Wichita, Kansas

S-f-61

(If additional description is necessary, use BACK of this sheet)  
Name of Plugging Contractor GARVEY DRILLING COMPANY  
Address ROUTE #2, GREAT BEND, KANSAS

STATE OF KANSAS, COUNTY OF BARTON, ss.  
DON SEARLE (employee of owner) or (owner or operator) of the above-described well, being first duly sworn on oath, says: That I have knowledge of the facts, statements, and matters herein contained and the log of the above-described well as filed and that the same are true and correct. So help me God.

(Signature) Don Searle  
ROUTE #2, GREAT BEND, KANSAS (Address)

SUBSCRIBED AND SWORN to before me this 5TH day of MAY, 19 61

Arthur J. Wiles  
Notary Public.

My commission expires APRIL 14, 1963



# WELL LOG

15-163-02835-00-00

COMPANY PETROLEUM, INCORPORATED

SEC. 32 T. 9S R. 16W

FARM COLAHAN "B" NO. 2

LOC. SW, NE, NE


TOTAL DEPTH 3505'

COUNTY ROOKS CO., KANSAS

COMM. April 18, 1961 COMP. April 27, 1961

CONTRACTOR GARVEY DRILLING COMPANY

CASING NONE

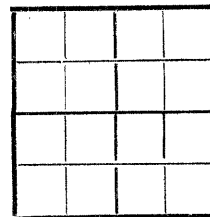

ELEVATION 2045' DF

PRODUCTION D & A

FIGURES INDICATE BOTTOM OF FORMATIONS

40	Surface soil & post rock
775	Sand, shale & shells
1000	Shale & sand
1254	Shale
<del>2190</del> 1290	Anhydrite
1300	Shale
1910	Shale & shells
2050	Lime & shale
2115	Shale
2225	Lime & shale
2590	Shale & lime
3160	Lime & shale
3460	Lime
3495	Lime & shale
3505	Lime
3505	T. D.

**RECEIVED**  
STATE CORPORATION COMMISSION

MAY 8 1961

CONSERVATION DIVISION  
Wichita, Kansas

5-8-61

State of KANSAS }  
County of BARTON } SS

I, VERNE A. MORRIS of GARVEY DRILLING COMPANY

upon oath state the above and foregoing is a true and correct copy of the log of the #1 COLAHAN "B" well.

Subscribed and sworn to before me this 2nd day of May 19 61

My Commission Expires: April 14, 1963

Verne A. Morris  
Arthur J. Wiles  
NOTARY PUBLIC