

WELL PLUGGING RECORD

Give All Information Completely
Make Required Affidavit
Mail or Deliver Report to
Conservation Division
State Corporation Comm.
245 North Water
Wichita, KS 67202

Rooks County Sec. 32 Twp. 9s Rge. 16 E/W
Location as "NE/CNW/SW" or footage from lines
NE NE SW

Lease Owner Liberty Enterprises, Inc.

Lease Name Colohan Well No. 1

Office Address 308 W. Mill Plainville, KS 67663

Character of Well (Completed as Oil, Gas or Dry Hole) Dry Hole

Date Well completed January 25 1981

Application for plugging filed January 25 1981

Application for plugging approved January 25 1981

Plugging commenced 8:00 a.m. January 25 1981


Plugging completed 9:15 a.m. January 25 1981

Reason for abandonment of well or producing formation no commercial production

If a producing well is abandoned, date of last production 19

Was permission obtained from the Conservation Division or its agents before plugging was commenced? yes

Name of Conservation Agent who supervised plugging of this well Marion Schmidt
Producing formation _____ Depth to top _____ Bottom _____ Tl. Depth of Well _____
Show depth and thickness of all water, oil and gas formations.

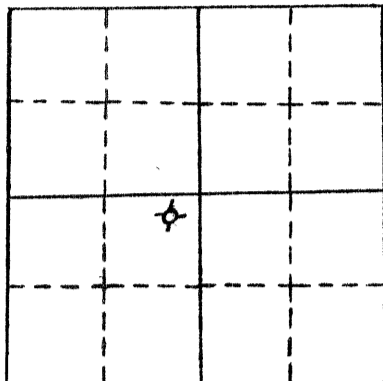

locate well correctly
on above
Section Plot

OIL, GAS OR WATER RECORDS

CASING RECORD

FORMATION	CONTENT	FROM	TO	SIZE	PUT IN	PULLED OUT
surface casing	common	0'	199.02'	8 5/8	199.02'	0'

Describe in detail the manner in which the well was plugged, indicating where the mud fluid was placed and the method or methods used in introducing it into the hold. If cement or other plugs were used, state the character of same and depth placed, from _____ feet to _____ feet for each plug set.

1st plug @ 740' with 70sxs
2nd plug @ 210' with 25sxs

3rd plug @ 40' with 1 wooden plug 1sxs hull & 10sxs

5sxs in rathole

105sxs 50-50 pos 6% gel

final plug down 9:15 A.M.

(If additional description is necessary, use BACK of this sheet)

Name of Plugging Contractor Pioneer Drilling Co, Inc.


STATE OF Kansas COUNTY OF Rooks, ss.

Connie Jo Austin (employee of owner) or (owner or operator) of the above described well, being first duly sworn on oath, says: That I have knowledge of the facts, statements, and matters herein contained and the log of the above described well is filed and that the same are true and correct. So help me God.

(Signature) Connie Jo Austin
(Address) 308 West Mill Plainville, Mo. 67663

SUBSCRIBED AND SWORN TO before me this 20th day of February, 1981

My commission expires

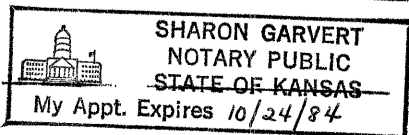

Sharon Garvert
Notary Public
Sharon Garvert