


STATE OF KANSAS
STATE CORPORATION COMMISSION

WELL PLUGGING RECORD

Give All Information Completely
Make Required Affidavit
Mail or Deliver Report to
Conservation Division
State Corporation Comm.
245 North Water
Wichita, KS 67202

Rooks _____ County. Sec. 33 Twp. 9 S Rge. 16 W E/W
Location as "NE/CNW $\frac{1}{4}$ SW $\frac{1}{4}$ " or footage from lines _____
SW NW NW
Lease Owner F & M Oil Co., Inc.
Lease Name Colohan Well No. I
Office Address 505 Union Center, Wichita, Kansas 67202
Character of Well (Completed as Oil, Gas or Dry Hole) _____

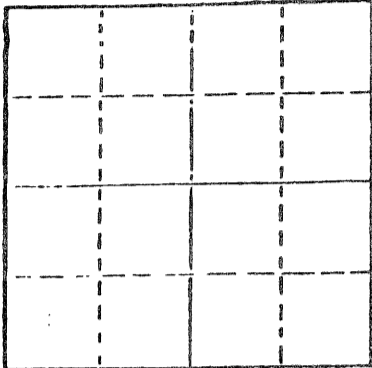

Locate well correctly on above Section Plat

Dry Hole
Date Well completed September 25 19 76
Application for plugging filed September 25 19 76
Application for plugging approved September 25 19 76
Plugging commenced September 25 19 76
Plugging completed September 25 19 76
Reason for abandonment of well or producing formation _____
Dry Hole

If a producing well is abandoned, date of last production _____ 19 _____

Was permission obtained from the Conservation Division or its agents before plugging was commenced? yes

Name of Conservation Agent who supervised plugging of this well Leo Massey
Producing formation _____ Depth to top _____ Bottom _____ Total Depth of Well 3536'
Show depth and thickness of all water, oil and gas formations.

OIL, GAS OR WATER RECORDS

CASING RECORD

FORMATION	CONTENT	FROM	TO	SIZE	PUT IN	PULLED OUT

Describe in detail the manner in which the well was plugged, indicating where the mud fluid was placed and the method or methods used in introducing it into the hold. If cement or other plugs were used, state the character of same and depth placed, from _____ feet to _____ feet for each plug set.

Hole full of heavy mud to 550' w/70 sacks cement (50/50 Pozmix) thru drill pipe.
Mud to 240' w/20 sacks 50/50 Pozmix thru drill pipe.
Mud to 40' w/ $\frac{1}{2}$ sack hulls plug and 10 sacks cement.

(If additional description is necessary, use BACK of this sheet) 9-29-76

Name of Plugging Contractor Duke Drilling Co.

STATE OF KANSAS COUNTY OF BARTON, ss.
Larry Curtis (employee of owner) or (~~owner~~)

of the above-described well, being first duly sworn on oath, says: That I have knowledge of the facts, statements, and matters herein contained and the log of the above-described well as filed and that the same are true and correct. So help me God.

(Signature) Larry Curtis
Box 823, Great Bend, Kansas
(Address)

SUBSCRIBED AND SWORN TO before me this 28th day of September, 19 76

My commission expires April 11, 1978

Rochey M. Hague
Notary Public.

15-163-20630-00-00

DRILLERS' WELL LOG

DATE COMMENCED: September 17, 1976
DATE COMPLETED: September 25, 1976

F & M Oil Co., Inc.
COLOHAN # 1
SW NW NW
Sec 33-T9S-R16W
Rooks County, Kansas

ELEVATION: 2043 K.B.

0 - 298'	Post Rock, Shale and Hard Sand
298 - 570'	Shale and Clay
570 - 1279'	Shale and Sand
1279 - 1286'	Anhydrite
1286 - 1725'	Shale
1725 - 2918'	Lime and Shale
2918 - 3143'	Lime
3143 - 3145'	Shale
3145 - 3163'	Lime and Shale
3163 - 3409'	Lime
3409 - 3520'	Lime and Shale
3520 - 3528'	Sand
3528 - 3536'	Dolomite
3536'	RTD

FORMATION TOPS

Anhydrite	1249
Topeka	2918
Heebner	3143
Toronto	3163
Lansing	3186
Base K.C.	3409
Simpson Sand	3520
Arbuckle	3528
RTD	3536

SURFACE PIPE:

Set used 8 5/8", 23# pipe
at 298' w/1.75 sacks Common,
2% Gel, 3% cc.

AFFIDAVIT

STATE OF KANSAS }
COUNTY OF BARTON } ss.

Larry Curtis, of lawful age, does swear and state that the facts and statements herein contained are true and correct to the best of his knowledge.

Larry Curtis

Subscribed and sworn to before me this 28th day of September, 1976.

Clarethy M. Hague
Notary Public

My Commission Expires: April 11, 1978