


STATE OF KANSAS
STATE CORPORATION COMMISSION

WELL PLUGGING RECORD

Give All Information Completely
Make Required Affidavit
Mail or Deliver Report to
Conservation Division
State Corporation Comm.
245 North Water
Wichita, KS 67202

Rooks County. Sec. 33 Twp. 9S Rge. 16 ~~E~~/W
Location as "NE/CNW $\frac{1}{4}$ SW $\frac{1}{4}$ " or footage from lines
SE SE NW

Lease Owner Rains & Williamson Oil Co., Inc.
Lease Name Ross Well No. #1
Office Address 435 Page Court, 220 W. Douglas, Wichita, Ks.
Character of Well (Completed as Oil, Gas or Dry Hole)
Dry Hole

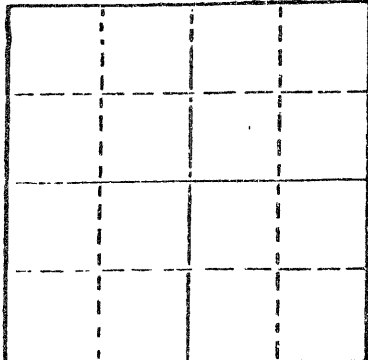

Locate well correctly on above
Section Plat

Date Well completed 12-30-80 19
Application for plugging filed 12-30-80 19
Application for plugging approved 12-30-80 19
Plugging commenced 12-30-80 19
Plugging completed 12-30-80 19
Reason for abandonment of well or producing formation
Commercial quantities of oil not found
If a producing well is abandoned, date of last production 19.

Was permission obtained from the Conservation Division or
its agents before plugging was commenced? Yes

Name of Conservation Agent who supervised plugging of this well Marion Schmidt
Producing formation Depth to top Bottom Total Depth of Well 3572'
Show depth and thickness of all water, oil and gas formations.

OIL, GAS OR WATER RECORDS

CASING RECORD

FORMATION	CONTENT	FROM	TO	SIZE	PUT IN	PULLED OUT
				8 5/8"	215'	None

Describe in detail the manner in which the well was plugged, indicating where the mud fluid
was placed and the method or methods used in introducing it into the hold. If cement or other
plugs were used, state the character of same and depth placed, from feet to
feet for each plug set.

Plug @ 740' w/70 sx.
Plug @ 210' w/25 sx.
Plug @ 40' w/10 sx.
Rat Hole 5 sx.

(If additional description is necessary, use BACK of this sheet)

Name of Plugging Contractor Rains & Williamson Oil Co., Inc.

STATE OF Kansas COUNTY OF Sedgwick, ss.
Wilson Rains, President of Rains & Williamson Oil Co., Inc. (employee of owner) or (owner or operator)
of the above-described well, being first duly sworn on oath, says: That I have knowledge of
the facts, statements, and matters herein contained and the log of the above-described well
as filed and that the same are true and correct. So help me God

(Signature) Wilson Rains
435 Page Court, 220 W. Douglas, Wichita, Kansas 67202
(Address)



AND SWORN TO before me this 10 day of January, 19 81

Sherry Herrell
Sherry Herrell Notary Public.

My commission expires 1-5-82

JAN 20 1981
120-51
CONSERVATION DIVISION
Wichita, Kansas

DRILLER'S LOG

15-163-21107-00-00

COMPANY: Rains & Williamson Oil Co., Inc.

SEC. 33 T. 9S R. 16W

WELL NAME: Ross #1

LOC. SE SE NW

COUNTY: Rooks

RIG NO. #11

TOTAL DEPTH 3572'

ELEVATION 2067_{GL} 2072 KB

COMMENCED: 12-20-80 COMPLETED: 12-30-80

CONTRACTOR: Rains & Williamson Oil Co., Inc.

CASING RECORD:

SURFACE: 8 5/8" @ 215' w/160 sx. 60/40 poz., 2% gel, 3% cc.

PRODUCTION: D&A

LOG

(Figures Indicate Bottom of Formations)

Shale	870
Sand	970
Shale	3572
<u>ROTARY TOTAL DEPTH</u>	<u>3572</u>

STATE OF KANSAS CONSERVATION DIVISION

JAN 20 1981

CONSERVATION DIVISION
Wichita, Kansas

1-20-81


STATE OF Kansas)

COUNTY OF Sedgwick)

SS:

I, Wilson Rains, President of Rains & Williamson Oil Co., Inc.

upon oath state that the above and foregoing is a true and correct copy of the log of the
Ross #1 well.

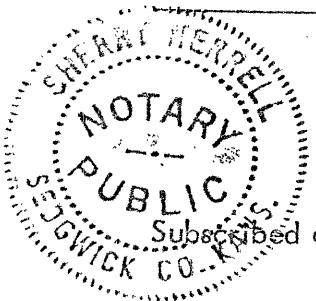

Wilson Rains
Wilson Rains

Subscribed and sworn to before me this 10 day of January, 1981.

My Appointment Expires:
1-5-82

Sherry Herrell
Sherry Herrell