


15-163-20579-00-00

Form CP-4

STATE OF KANSAS
STATE CORPORATION COMMISSION

Give All Information Completely
Make Required Affidavit
Mail or Deliver Report to:
Conservation Division
State Corporation Commission
P. O. Box 17027
Wichita, Kansas 67217
NORTH

WELL PLUGGING RECORD

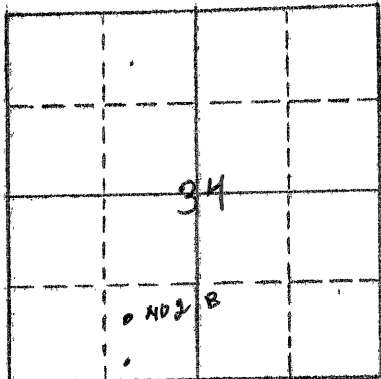

Locate well correctly on above
Section Plat

Location as "NE/CNW/SE/SW" or footage from lines Rooks County, Sec. 34 Twp. 9S Rge. 16W (E) (W)
C SE SW
Lease Owner Harold Krueger
Lease Name Becker Well No. 2
Office Address Natoma, Kansas
Character of Well (completed as Oil, Gas or Dry Hole) D & A
Date well completed September 22, 1975
Application for plugging filed September 22, 1975
Application for plugging approved September 22, 1975
Plugging commenced September 22, 1975
Plugging completed September 22, 1975
Reason for abandonment of well or producing formation D & A

If a producing well is abandoned, date of last production 19
Was permission obtained from the Conservation Division or its agents before plugging was commenced? Yes

Name of Conservation Agent who supervised plugging of this well Mr. Leo F. Massey
Producing formation _____ Depth to top _____ Bottom _____ Total Depth of Well 3551 Feet
Show depth and thickness of all water, oil and gas formations.

OIL, GAS OR WATER RECORDS

CASING RECORD

FORMATION	CONTENT	FROM	TO	SIZE	PUT IN	PULLED OUT
				8-5/8"	272'	-0-

Describe in detail the manner in which the well was plugged, indicating where the mud fluid was placed and the method or methods used in introducing it into the hole. If cement or other plugs were used, state the character of same and depth placed, from _____ feet to _____ feet for each plug set.

Plug #1 @ 550' w/70 sx. cmt.
Plug #2 @ 240' w/20 sx. cmt.
Plug #3 @ 40' w/10 sx. cmt. & 1 sk. hulls
Cmt. was 50-50 pozmix, 2% gel.

RECEIVED
STATE CORPORATION COMMISSION

SEP 30 1975

9/30/75

CONSERVATION DIVISION
Wichita, Kansas

Name of Plugging Contractor Red Tiger Drilling Company
Address 1720 Wichita Plaza, Wichita, Kansas 67202


STATE OF Kansas COUNTY OF Sedgwick ss.
Linda H. Dickens (employee of owner) or ~~(XXXXXXXXXX)~~ of the above-described

well being first duly sworn on oath, says: That I have knowledge of the facts, statements, and matters herein contained and the log of the above-described well as filed and that the same are true and correct. So help me God.

(Signature) Linda H. Dickens
1720 Wichita Plaza, Wichita, Kansas 67202
(Address)

sworn to before me this 23rd day of September, 1975

December 28, 1977

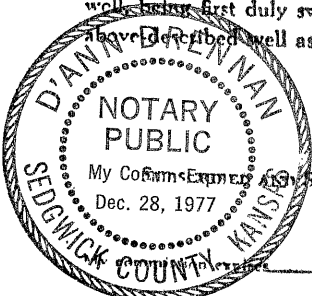

D'Ann Duran
Notary Public.

15-163-20579-00-00

DRILLERS LOG

No. 2 Becker

CASING RECORD:	COMPANY:	Harold Krueger	DESCRIPTION:
8-5/8" @ 272' w/170 sx. cmt.	CONTRACTOR:	Red Tiger Drilling Company	C SE SW 34-9S-16W Rooks County, Kansas
	COMMENCED:	September 12, 1975	
	COMPLETED:	September 22, 1975	

TOTAL DEPTH: 3551'

ELEVATION: 2047' D.F.

<u>FORMATION</u>	<u>FROM</u>	<u>TO</u>	<u>REMARKS</u>
Surface Clay & Shale	0	70	
Shale	70	275	
Shale & Clay	275	1030	
Shale	1030	1225	
Anhydrite	1225	1259	
Shale	1259	1880	
Shale & Lime Streaks	1880	2125	
Lime & Shale	2125	2229	
Shale & Lime	2229	2430	
Lime & Shale	2430	2860	
Lime	2860	3425	
Lime & Shale	3425	3480	
Lime	3480	3551	

RECEIVED
STATE CORPORATION COMMISSION
SEP 30 1975
CONSERVATION DIVISION
Wichita, Kansas
9/30/75

I certify that this is a true and correct copy of the above log to the best of my knowledge.

RED TIGER DRILLING COMPANY

Linda H. Dickens
Linda H. Dickens

Subscribed and sworn to before me this 23rd day of September, 1975.

D'Ann Drennan
Notary Public

My Commission Expires:

December 28, 1977

