


Give All Information Completely
Make Required Affidavit
Mail or Deliver Report to:
Conservation Division
State Corporation Commission
800 Biting Building
Wichita, Kansas

OR
FORMATION PLUGGING RECORD

Strike out upper line
when reporting plug-
ging off formations.

NORTH

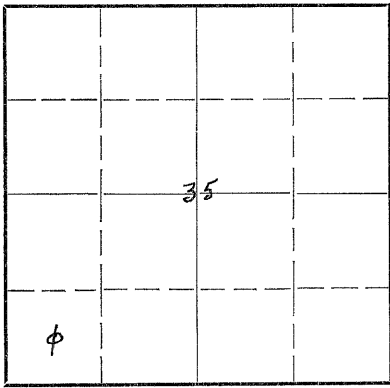

Locate well correctly on above
Section Plat

Rooks County Sec. 35 Twp. 9 Rge. 16 (E) W (W)
Location as "NE $\frac{1}{4}$ NW $\frac{1}{4}$ SW $\frac{1}{4}$ " or footage from lines C SW SW
Lease Owner Co-Op. & Allan
Lease Name Hedges Well No. 1
Office Address North Kansas City, Missouri
Character of Well (completed as Oil, Gas or Dry Hole) Dry Hole
Date well completed November 15 1943
Application for plugging filed November 15 1943
Application for plugging approved November 15 1943
Plugging commenced November 16 1943
Plugging completed November 16 1943
Reason for abandonment of well or producing formation No Oil

If a producing well is abandoned, date of last production _____ 19____
Was permission obtained from the Conservation Division or its agents before plugging was com-
menced? Yes

Name of Conservation Agent who supervised plugging of this well C. T. Alexander
Producing formation Lansing-Kansas City Depth to top 3190' Bottom 3408' Total Depth of Well 3408' Feet
Show depth and thickness of all water, oil and gas formations.



OIL, GAS OR WATER RECORDS

CASING RECORD

Formation	Content	From	To	Size	Put In	Pulled Out
				8-5/8"	126'	None
Drilled by Rotary - See sample log attached.						

Describe in detail the manner in which the well was plugged, indicating where the mud fluid was placed and the method or methods used in introducing it into the hold. If cement or other plugs were used, state the character of same and depth placed, from _____ feet to _____ feet for each plug set.

Heavy rotary mud from 3408' to 126'
Bridge at 126'
Cement to 106'
Mud and bridge to 20'
Cement to 5' to top of hole

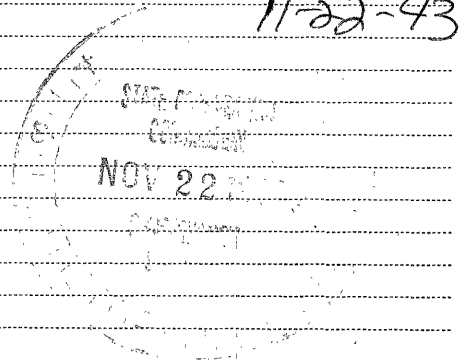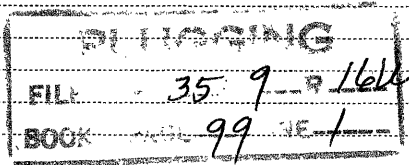

(If additional description is necessary, use BACK of this sheet)

Correspondence regarding this well should be addressed to Thos. H. Allan
Address 921 Union National Bank Bldg., Wichita, 2, Kansas

STATE OF KANSAS COUNTY OF SEDGWICK, ss.

Thos. H. Allan (employer or owner) of the above-described well,
being first duly sworn on oath, says: That I have knowledge of the facts, statements, and matters herein contained and the log of the above-described well as filed and that the same are true and correct. So help me God.

(Signature) Thos. H. Allan

921 Union National Bank Bldg., Wichita 2, Kansas
(Address)

SUBSCRIBED AND SWORN to before me this 18th day of November, 1943

My commission expires February 7, 1944.

Ruth Newcomer
Notary Public.



Casing Record

8-5/8" @ 126'

15-163-02938-00-00
Rocks County, Kansas

Co-Op. & Allan #1 Hedges
Loc: C SW SW Sec. 35, T. 9S., R. 16W.
Commenced: 10/31/43 Completed: 11/17/43
Contractor: Thos. H. Allan
I.P. Dry & Abandoned
Elevation: 2033'

0 -	55	chalk	3190	red shale
	126	blue shale	3198	Lansing lime - slight show oil
	126	8-5/8" Cemented	3213	red & green shale
	400	blue shale	3225	lime - slight show oil
	440	black shale	3230	lime - probably water
	500	dark sandy shale	3265	lime
	600	dark shale	3270	shale
	710	red & gray shale	3304	lime
	820	shale & sandy concretions	3320	gray shale
	930	white sand - water	3330	white cherty lime
	1050	red shale	3347	gray & red shale
	1200	red sandy grit	3376	lime - Base Kansas City
	1210	red shale	3390	red shale
	1244	white anhydrite	3408	shale & shells
	1480	red shale	3408	Total Depth
	1730	gray shale, salt & anhydrite		
	1800	anhydrite & shale		
	1970	shale & shells		
	2000	red shale		
	2010	anhydrite		
	2090	shale, dolomite & lime		
	2220	red shale		
	2235	dense lime		
	2310	shale & lime shells		
	2340	red shale		
	2380	Neva lime porous		
	2770	shale & shells		
	2810	lime		
	2890	shale & shells		
	2900	sandy shale		
	2911	shale		
	2916	Topeka lime		
	2930	shale		
	2952	lime		
	2960	shale		
	2983	lime		
	2990	shale		
	2995	cherty lime		
	3000	shale		
	3012	porous lime - probably water		
	3034	shale		
	3055	dense white lime		
	3083	shale		
	3092	fossiliferous lime		
	3105	shale		
	3113	lime		
	3128	shale		
	3140	lime		
	3145	black shale		
	3158	shale		
	3173	dense white lime - Slight show oil		

DRILLING
 FILE 35 9-16W
 BOOK 99-1

I certify that the log above is a true and correct copy of the well log of this test.

Thos. H. Allan
 STATE CORPORATION COMMISSION
 NOV 22 1943
 11-22-43