


STATE OF KANSAS
STATE CORPORATION COMMISSION

Form CP-4

Give All Information Completely
Make Required Affidavit
Mail or Deliver Report to:
Conservation Division
State Corporation Commission
212 No. Market
Wichita, Kansas

WELL PLUGGING RECORD

NORTH

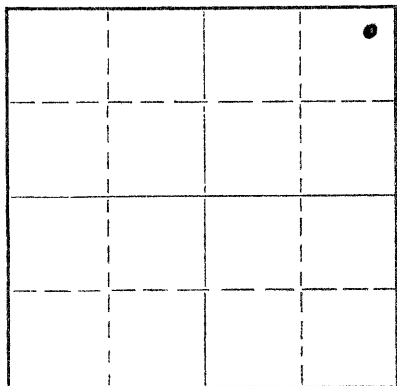

Locate well correctly on above
Section Plat

GRAHAM

County. Sec. ³² 29 Twp. 9 Rge. 21 (E) (W)

Location as "NE/CNWxSWx" or footage from lines. NE NE NE

Lease Owner Ralph R. Rhyne

Lease Name Eichman Well No. 1

Office Address Box 385, Russell, Kansas 67665

Character of Well (completed as Oil, Gas or Dry Hole) Oil

Date well completed _____ 19__

Application for plugging filed 6-27-67 19__

Application for plugging approved 6-28-67 19__

Plugging commenced 9-8-67 19__

Plugging completed 11 am 9-11-67 19__

Reason for abandonment of well or producing formation _____

Depleted

If a producing well is abandoned, date of last production _____ 19__

Was permission obtained from the Conservation Division or its agents before plugging was commenced? yes

Name of Conservation Agent who supervised plugging of this well W. L. Nichols

Producing formation _____ Depth to top _____ Bottom _____ Total Depth of Well 3918 Feet

Show depth and thickness of all water, oil and gas formations.

OIL, GAS OR WATER RECORDS

CASING RECORD

FORMATION	CONTENT	FROM	TO	SIZE	PUT IN	PULLED OUT
				8 5/8	220	none
				5 1/2	3912	none

Describe in detail the manner in which the well was plugged, indicating where the mud fluid was placed and the method or methods used in introducing it into the hole. If cement or other plugs were used, state the character of same and depth placed, from _____ feet to _____ feet for each plug set.

Checked hole, sanded back from 3918' to 3858'.
Dumped 5 sacks cement with dump bailer.
pushed plug to 1500', sanded back to 1440'
dumped 5 sacks cement with dump bailer,
bailed hole dry, filled with 7 yds Ready-mix concrete to cellar

RECEIVED
9/25/67
SEP 25 1967
CONSERVATION DIVISION
STATE CORPORATION COMMISSION
WICHITA, KANSAS

(If additional description is necessary, use BACK of this sheet)

Name of Plugging Contractor _____

Address _____

STATE OF KANSAS, COUNTY OF RUSSELL, ss.

RALPH R. RHYNE (employee of owner) or (matter or operator) of the above-described well, being first duly sworn on oath, says: That I have knowledge of the facts, statements, and matters herein contained and the log of the above-described well as filed and that the same are true and correct. So help me God.

(Signature) Ralph R. Rhyne

Box 385 Russell Kansas
(Address)

SUBSCRIBED AND SWORN TO before me this 20th day of September, 19 67

My commission expires September 27, 1971

Helma Underwood
Notary Public.

H & L DRILLING, INC. - R. A. COOK
Richard #1

NE 1/4 Sec. 32-9-21W
Graham County, Kansas

Comm: March 14, 1956
Comp: March 22, 1956
Total Depth: 3918'

<u>Casing</u>	<u>Cement</u>
3 5/8" Set @ 220'	150 sacks
5 1/2" Set @ 3918'	500 sacks
3912 <i>open hole</i>	(100 sac out bottom of casg.) (450 sac out DV Tool @ 1840')

<u>FORMATION</u>	<u>DEPTH</u>
Sand	0 - 110
Shale & shells	110 - 810
Sand & shale	810 - 1555
Shale & shells	1555 - 1803
Anhydrite	1803 - 1850
Shale & shells	1850 - 2150
Lime & shale	2150 - 3210
Lime	3210 - 3524
Shale	3524 - 3530
Lime - shale	3530 - 3555
Lime - K.C.	3555 - 3590
Lime	3590 - 3885
Lime & Congl	3885 - 3911
Arbuckle Lime	3911 - 3918

STATE OF KANSAS)
) SS
 SEDGWICK COUNTY)

I hereby certify that the above information is true and correct to the best of my knowledge.

[Signature]

Subscribed and sworn to before me this 26th day of March, 1956.

[Signature]
Notary Public

My commission expires: June 25, 1956

RECEIVED
STATE CORPORATION COMMISSION

SEP 25 1967

REGISTRATION DIVISION
Wichita, Kansas