


15-065-02404-00-00

STATE OF KANSAS
STATE CORPORATION COMMISSION

Give All Information Completely
Make Required Affidavit
Mail or Deliver Report to:
Conservation Division
State Corporation Commission
800 Bitting Building
Wichita, Kansas

WELL PLUGGING RECORD

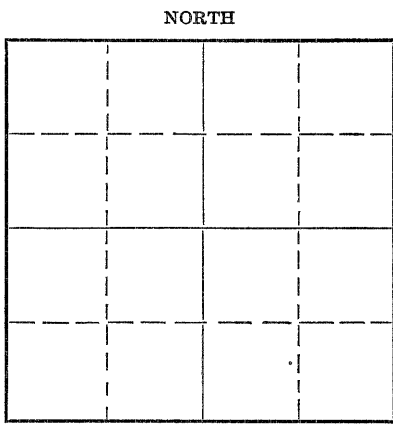

Locate well correctly on above
Section Plat

GRAHAM County. Sec. 32 Twp. 9S Rge. 10E (E) 10W (W)
Location as "NE/CNW 1/4 SW 1/4" or footage from lines SW 1/4 SW 1/4 NW 1/4
Lease Owner Aylward Drilling Company, et al
Lease Name Eichman Well No. 1
Office Address 813 First National Bank Bldg., Wichita, Kansas
Character of Well (completed as Oil, Gas or Dry Hole) Dry
Date well completed February 24, 19 52
Application for plugging filed February 25, 19 52
Application for plugging approved 19
Plugging commenced February 24, 19 52
Plugging completed February 24, 19 52
Reason for abandonment of well or producing formation Dry
If a producing well is abandoned, date of last production 19
Was permission obtained from the Conservation Division or its agents before plugging was commenced? Yes

Name of Conservation Agent who supervised plugging of this well
Producing formation Depth to top Bottom Total Depth of Well 3932 Feet
Show depth and thickness of all water, oil and gas formations.

OIL, GAS OR WATER RECORDS CASING RECORD

Formation	Content	From	To	Size	Put In	Pulled Out
				8-5/8	215	0

Describe in detail the manner in which the well was plugged, indicating where the mud fluid was placed and the method or methods used in introducing it into the hole. If cement or other plugs were used, state the character of same and depth placed, from feet to feet for each plug set.

Filled hole with mud to 210', set plug at 210', put 1/2 sack hulls and 15 sack cement.
Filled hole with mud to 40', set plug at 40' with 1/2 sack hulls on plug and bridged same with post rock, cemented with 10 sack cement to bottom of cellar.

2/27/52


(If additional description is necessary, use BACK of this sheet)
Name of Plugging Contractor Aylward Drilling Company
Address 813 First National Bank Bldg., Wichita, Kansas

STATE OF Kansas COUNTY OF Sedgwick, ss.
Al Skalsky (employee of owner) or (owner or operator) of the above-described well,
being first duly sworn on oath, says: That I have knowledge of the facts, statements, and matters herein contained and the log of the above-described well as filed and that the same are true and correct. So help me God.

(Signature) [Signature of Al Skalsky]
813 First National Bank Bldg., Wichita, Kans.
(Address)

SUBSCRIBED AND SWORN to before me this 25th day of February, 19 52.

My commission expires July 16, 1952. [Signature of Notary Public] Notary Public.

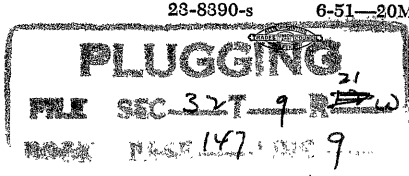

23-8390-s 6-51-20M

HIGHMAN #1

Casing Records:
8-5/8" - 215'

Company: Aylward Drilling Company No. A1
Contractor: Aylward Drilling Company
Commenced: February 12, 1952
Completed: February 24, 1952

Description:
SW/4 SW/4 NW/4
Sec. 32-98-27 2/
Graham County, Kansas
Elev: 2305' D.F.
D. & A.

	<u>From</u>	<u>To</u>	<u>Remarks</u>
Clay & Sand	0	40	
Sand	40	70	
Surface Soil & Sand	70	100	
Sand Shale	100	185	
Shale	185	790	Set 8-5/8" casing at 215'
Sand	790	1150	and cemented with 125 sacks.
Shale & Sand	1150	1620	
Red Bed & Shale Sand	1620	1778	
Anhydrite	1778	1820	
Shale & Shells	1820	1985	
Shale & Lime Shell	1985	2105	
Shale & Shell	2105	2245	
Lime & Shale	2245	2410	
Shale & Lime Shell	2410	2510	
Lime & Shale	2510	3555	
Lime	3555	3932	T.S.

TOPS:

Heehner 3502' - 1197'
Lensing 3546' - 1239'

D.S.T. 3574 to 3602', open 1 hour, work blow for 2 min., recovered 5' mud, H.H.P. zero.

I certify that this is a true and correct copy of the above log to the best of my knowledge.

Al Skalsky
Al Skalsky

Subscribed and Sworn to before me this 25th day of February, 1952.

My Commission Expires
July 16, 1952

Florus Cooper
Notary Public

PLUGGING
PAGE 147 LINE 9