

STATE OF KANSAS
STATE CORPORATION COMMISSION


WELL PLUGGING RECORD

Give All Information Completely
Make Required Affidavit
Mail or Deliver Report to:
Conservation Division
State Corporation Commission
800 Bitting Building
Wichita, Kansas

OR
FORMATION PLUGGING RECORD

Strike out upper line
when reporting plug-
ging off formations.

NORTH

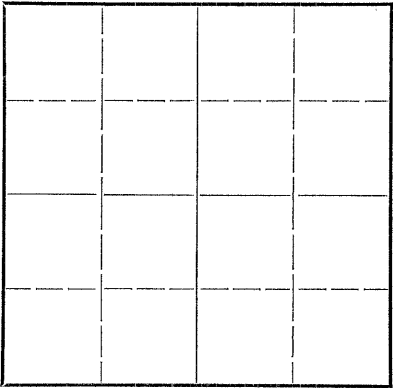

Locate well correctly on above
Section Plat

Graham County. Sec. 26 Twp. 9S Rge. 21 (E).....(W)
Location as "NE $\frac{1}{4}$ NW $\frac{1}{4}$ SW $\frac{1}{4}$ " or footage from lines..... SE NE NE
Lease Owner..... Hinkle Oil Company & Franco Central Oil Company
Lease Name..... Box Well No. 1
Office Address..... 914 Union National Bank Bldg., Wichita, Kansas.
Character of Well (completed as Oil, Gas or Dry Hole)..... D & A
Date well completed..... 1-9-48.....19
Application for plugging filed..... 1-9-48.....19
Application for plugging approved..... 1-9-48 KEL ZAP.....19
Plugging commenced..... 1-9-48.....19
Plugging completed..... 1-9-48.....19
Reason for abandonment of well or producing formation.....

If a producing well is abandoned, date of last production.....19
Was permission obtained from the Conservation Division or its agents before plugging was com-
menced?..... Corporation Commission Office

Name of Conservation Agent who supervised plugging of this well.....
Producing formation..... Depth to top..... Bottom..... Total Depth of Well..... Feet
Show depth and thickness of all water, oil and gas formations.

OIL, GAS OR WATER RECORDS

CASING RECORD

Formation	Content	From	To	Size	Put In	Pulled Out
				8 5/8"	186'	none

Describe in detail the manner in which the well was plugged, indicating where the mud fluid was placed and the method or methods used in introducing it into the hold. If cement or other plugs were used, state the character of same and depth placed, from.....feet to.....feet for each plug set.

Mud to 180' from 3800'
Set wood plug at 180'
Cemented with 15 sax cement.
Mud to 40'
Set wood plug at 40'
cemented with 10 sax cement.
mud to top of hole.

(If additional description is necessary, use BACK of this sheet)

Correspondence regarding this well should be addressed to..... Hinkle Oil Company
Address..... 914 Union National Bank Bldg., Wichita, Kansas.


STATE OF Kansas, COUNTY OF Sedgwick, ss.

J. B. Hinkle (~~employee of owner~~ or (~~owner or operator~~) of the above-described well,
being first duly sworn on oath, says: That I have knowledge of the facts, statements, and matters herein contained and the log of the above-described well as filed and that the same are true and correct. So help me God.

(Signature) J. B. Hinkle
914 Union National Bank Bldg., 1/15/48
(Address)

SUBSCRIBED AND SWORN TO before me this 14th day of January, 19 48

My commission expires Jan. 17, 1950
Muriel G. Upton Notary Public.

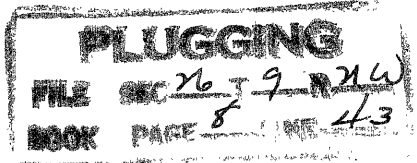

Casing record.
8" 176'

Cox No. 1. SE NE NE 26-9S-21W Graham Co. Kansas.
France Central and Hinkle Oil Company,
Contractor, J. B. Hinkle.
Commenced Dec. 28, 1947 Completed Jan. 9, 1948.
Elevation 2248

0	176	shale and sand
176	960	shale
960	1460	shale and shells and sand
1460	1719	shale and shells
1719	1760	Anhydrite
1760	2140	shale and shells
2140	2241	shale and lime
2241	2340	shale and shells
2340	2435	shale
2435	2500	lime
2500	2716	lime and shale
2716	2728	shale
2728	2807	lime
2807	2951	lime and shale
2951	3046	shale
3046	3430	lime and shale
3430	3525	lime and shale
3525	3580	lime and shale
3580	3743	lime
3743	3798	lime and shale
3798	3800	Arb. or chert.

Keokuk	
Anhydrite	1719
Keokuk	3429
Toronto	3456
K. C. lime	3478
Base K. C.	3783
Arb.	3794

State of Kansas)
) ss
County of Sedwick)

I hereby certify that the above is a true and correct log as compiled from the daily drilling reports kept on said well.

J. B. Hinkle

Subscribed to and sworn to before me this 14th day of January, 1948.

Murriel A. Upton
N. P.

My commission expires 1-17-50.

