

15-065-01497-00-00


STATE OF KANSAS
STATE CORPORATION COMMISSION

WELL PLUGGING RECORD

Give All Information Completely
Make Required Affidavit
Mail or Deliver Report to:
Conservation Division
State Corporation Commission
800 Bittling Building
Wichita, Kansas

Graham County. Sec. 26 Twp. 9 Rge. 21 (E) (W)
Location as "NE/CNW/SW" or footage from lines ~~NE NE NW~~ NW NE NW ~~KCC~~ CAP
Lease Owner Bennett & Roberts Oil Operations
Lease Name Cox "A" Well No. 2
Office Address Drawer 232 Russell, Kansas
Character of Well (completed as Oil, Gas or Dry Hole) Oil
Date well completed 12/6/54 19.
Application for plugging filed 5/10/54 19.
Application for plugging approved 5/11/54 19.
Plugging commenced 5/18/54 19.
Plugging completed 5/25/54 19.
Reason for abandonment of well or producing formation Not enough oil to produce economically.
If a producing well is abandoned, date of last production 1/6/54 19.
Was permission obtained from the Conservation Division or its agents before plugging was commenced? yes

NORTH

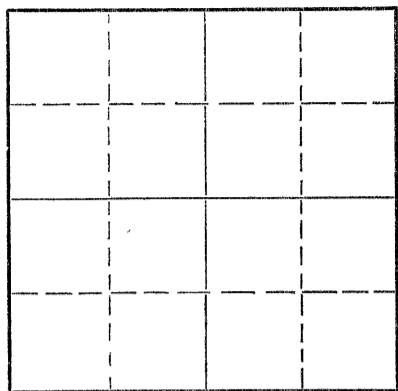

Locate well correctly on above Section Plat

Name of Conservation Agent who supervised plugging of this well Eldon Petty Hays, Kansas
Producing formation Arbuckle Depth to top 3813 Bottom 3 Total Depth of Well 3850 Feet
Show depth and thickness of all water, oil and gas formations.

OIL, GAS OR WATER RECORDS

CASING RECORD

FORMATION	CONTENT	FROM	TO	SIZE	PUT IN	PULLED OUT
				8 5/8"	187'	None
				5 1/2"	3813'	905'

Describe in detail the manner in which the well was plugged, indicating where the mud fluid was placed and the method or methods used in introducing it into the hole. If cement or other plugs were used, state the character of same and depth placed, from _____ feet to _____ feet for each plug set.

Plugged back with crushed rock from 3850' to 3800'. Dumped 4 sax cement at 3800' with dump bailer, top of cement, 3773'. Filled hole with mud to 185', set rock bridge, dumped 15 sax cement. Top of cement 148'. Filled with mud to 35', set rock bridge, dumped 10 sax cement for cap.

(If additional description is necessary, use BACK of this sheet)
Name of Plugging Contractor J & M Casing Pulling Company
Address Box 711 Great Bend, Ks.

STATE OF KANSAS, COUNTY OF RUSSELL, ss.
Harold Wurst (employee of owner) or (owner or operator) of the above-described well, being first duly sworn on oath, says: That I have knowledge of the facts, statements, and matters herein contained and the log of the above-described well as filed and that the same are true and correct. So help me God.

(Signature) Harold Wurst
Russell, Kansas (Address)

SUBSCRIBED AND SWORN TO before me this 1st day of June, 19 54

My commission expires 11-28-56
Lillian A. Habert Notary Public.

PLUGGING
FILE SEC 26 T 9 R 21 W
BOOK PAGE 33 LINE 24

RECEIVED
STATE CORPORATION COMMISSION
6/2/54
CONSERVATION DIVISION
Wichita, Kansas

Cox #2
B & R Drilling, Inc.

^{KCC}
~~NE~~ NW 26-9-21
Graham County, Kansas

Total Depth: 3816
Comm: 11/22/48 Comp: 12/6/48

Tops
Lansing K.C. 3502'
Arbuckle 3813'
Cement
100 sax - Lone Star
100 sax - Lone Star

Casing
8 5/8 Set at 187'
5 1/2 Set at 3813'

<u>Formation</u>	<u>Depth</u>
Surface Clay	40'
Sand & Shale	70
Sand	90
Shale & Shells	125
Sand	160
Shale, Sand & Shells	187
Shale & Shells	520
Sand	585
Shale & Shells	870
Sand, Shale & Shells	1090
Shale & Shells	1260
Sand	1580
Shale & Shell	1665
Shale, Red Bed & Shells	1755
Anhydrite	1794
Shale & Shells	1980
Shale & Lime Shell	2165
Lime & Shale	2710
Lime	2755
Lime & Shale	3500
Lime	3816

On April 8, 1954, Bennett & Roberts Oil Operations moved in cable tools to drill the hole deeper for a salt water disposal well. Drilled from 3816 to 3852, all lime formation. Couldn't get deeper because hole was caving, so it was plugged and abandoned on 5/25/54.

BENNETT & ROBERTS OIL OPERATIONS

By Sylvia Day

Subscribed and sworn to before me this 13th day of October, 1954.

Clara L. Lussner
Notary Public

My commission expires 6/17/54.