

STATE OF KANSAS  
STATE CORPORATION COMMISSION

WELL PLUGGING RECORD

Give All Information Completely  
Make Required Affidavit  
Mail or Deliver Report to:  
Conservation Division  
State Corporation Commission  
800 Bittig Building  
Wichita, Kansas

Graham County, Sec. 26 Twp. 9S Rge. (E) 21(W)

Location as "NE/CNW<sup>1</sup>/<sub>4</sub>SW<sup>1</sup>/<sub>4</sub>" or footage from lines SE SE NE

Lease Owner The Derby Oil Company

Lease Name Cox "A" Well No. 2

Office Address P.O. Box 1030, Wichita, Kansas

Character of Well (completed as Oil, Gas or Dry Hole) Dry Hole

Date well completed April 28 19 49

Application for plugging filed April 28 19 49

Application for plugging approved April 28 19 49


Plugging commenced April 28 19 49

Plugging completed April 28 19 49

Reason for abandonment of well or producing formation Dry Hole

If a producing well is abandoned, date of last production \_\_\_\_\_ 19 \_\_\_\_

Was permission obtained from the Conservation Division or its agents before plugging was commenced? Yes

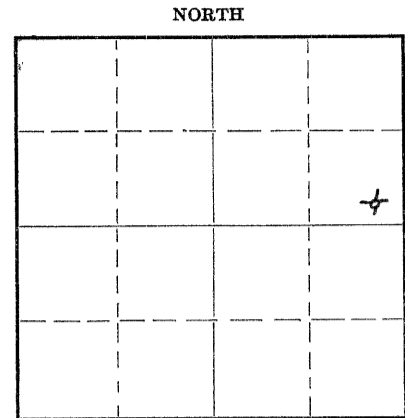

Locate well correctly on above Section Plat

Name of Conservation Agent who supervised plugging of this well E. R. Petty

Producing formation \_\_\_\_\_ Depth to top \_\_\_\_\_ Bottom \_\_\_\_\_ Total Depth of Well 3822 Feet

Show depth and thickness of all water, oil and gas formations.

OIL, GAS OR WATER RECORDS

CASING RECORD

Formation	Content	From	To	Size	Put In	Pulled Out
		0	217'	8 5/8"	217'	None

Describe in detail the manner in which the well was plugged, indicating where the mud fluid was placed and the method or methods used in introducing it into the hole. If cement or other plugs were used, state the character of same and depth placed, from \_\_\_\_\_ feet to \_\_\_\_\_ feet for each plug set.

3822' - 216 1/2' - Heavy Rotary Mud  
 216 1/2' - 215' - Wooden Plug  
 215' - 177 1/2' - 15 sacks cement  
 177 1/2' - 36 1/2' - Heavy Rotary Mud  
 36 1/2' - 35' - Wooden Plug  
 35' - 6' - 16 sacks cement and rock  
 6' - surface - cellar

5/17/49

(If additional description is necessary, use BACK of this sheet)

Correspondence regarding this well should be addressed to The Derby Oil Company  
Address P.O. Box 1030, Wichita, Kansas

STATE OF Kansas, COUNTY OF Barton, ss.


Glenn Peel Drilling Company, Inc. (employee of owner) or (owner or operator) of the above-described well, being first duly sworn on oath, says: That I have knowledge of the facts, statements, and matters herein contained and the log of the above-described well as filed and that the same are true and correct. So help me God.

(Signature) BY: [Signature]  
GLINN PEEL DRILLING COMPANY, INC.  
P.O. Box 359, Holsington, Kansas  
(Address)

SUBSCRIBED AND SWORN TO before me this 4th day of May, 19 49

My commission expires June 4, 1951

Marion M. Herbst  
Notary Public.

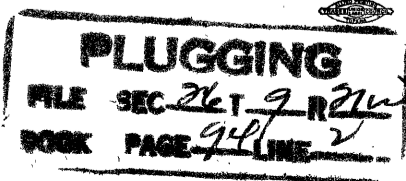

DRILLER'S LOG

Company: Derby Oil Company  
Glenn W. Peel Oil Producer

Sec. 26 Twp. 9S Rge. 21W  
SE SE NE

Farm: Cox "A" Well No. 2

County: Graham,  
Kansas

Total Depth: 3822'

Comm.: 4-17-49 Comp. 4-28-49

Elevation:

Contractor: Glenn Peel Drilling Company, Inc.

Production: Dry

Casing:

3 5/8" 217' cem.

Figures below indicate bottom of formations

Sand	0 -	25
Clay and Shale		105
Sand, Shells and Shale		218
Shale		760
Shale and Sand		865
Shale and Shells		1070
Sand		1125
Shale and Shells		1712
Anhydrite		1750
Shale and Shells		2160
Shale and Broken Lime		2320
Lime and Shale		2427
Shale and Lime		2445
Lime		2652
Lime and Shale		3160
Shale and Lime		3285
Lime and Shale		3445
Lime		3822
Total Depth		3822

This is to certify that the above information is, to the best of our knowledge, true and correct.

RECEIVED

GLENN PEEL DRILLING COMPANY, INC.

MAY 7 - 1949

BY: J. B. Anderson

STATE CORPORATION  
COMMISSIONER  
KANSAS

SUBSCRIBED AND SWORN to before me this 4th day of May, 1949

My commission expires June 4, 1951

Marian M. Nestel  
Notary Public

