


WELL PLUGGING RECORD

Give All Information Completely  
Make Required Affidavit  
Mail or Deliver Report to:  
Conservation Division  
State Corporation Commission  
800 Biting Building  
Wichita, Kansas

Graham County. Sec. 33 Twp. 9S Rge. 21 (E) SSSSS (W)  
Location as "NE/CNW/SW" or footage from lines 165'E & 165'S SW NE SE  
Lease Owner Herman Geo. Kaiser - Francis Oil and Gas  
Lease Name Bragg B Well No. 1  
Office Address 908 Palace Bldg. Tulsa, Oklahoma  
Character of Well (completed as Oil, Gas or Dry Hole) Dry hole  
Date well completed 11-1-55 19  
Application for plugging filed 11-1-55 19  
Application for plugging approved 11-1-55 19  
Plugging commenced 11-1-55 19  
Plugging completed 11-1-55 19  
Reason for abandonment of well or producing formation  
commercial quantities of oil not found  
If a producing well is abandoned, date of last production \_\_\_\_\_ 19  
Was permission obtained from the Conservation Division or its agents before plugging was com-  
menced? yes

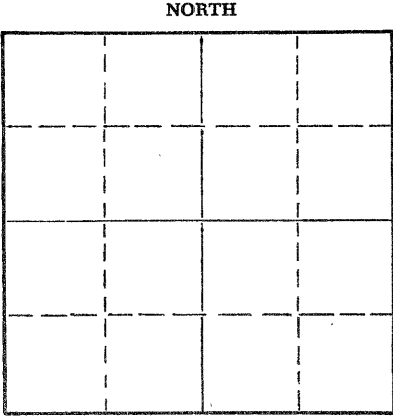

Locate well correctly on above  
Section Plat

Name of Conservation Agent who supervised plugging of this well Eldon Petty  
Producing formation \_\_\_\_\_ Depth to top \_\_\_\_\_ Bottom \_\_\_\_\_ Total Depth of Well 3890 Feet  
Show depth and thickness of all water, oil and gas formations.

OIL, GAS OR WATER RECORDS CASING RECORD

FORMATION	CONTENT	FROM	TO	SIZE	PUT IN	PULLED OUT
				8 5/8	227'	none

Describe in detail the manner in which the well was plugged, indicating where the mud fluid was placed and the method or methods used in introducing it into the hole. If cement or other plugs were used, state the character of same and depth placed, from \_\_\_\_\_ feet to \_\_\_\_\_ feet for each plug set.

Filled hole with heavy mud from 3890'  
to 225'. Set wooden plug with 1/2 sk hulls and 15 sks cement  
Second plug at 35' and capped with 10 sacks cement.


(If additional description is necessary, use BACK of this sheet)  
Name of Plugging Contractor K & E DRILLING, INC.  
Address 1006 Central Bldg., Wichita, Kansas

STATE OF Kansas, COUNTY OF Sedgwick, ss.  
Dale Silcott (employee of owner) or (owner or operator) of the above-described well, being first duly sworn on oath, says: That I have knowledge of the facts, statements, and matters herein contained and the log of the above-described well as filed and that the same are true and correct. So help me God.

(Signature) Dale Silcott  
1006 Central Bldg., Wichita, Kansas  
(Address)

SUBSCRIBED AND SWORN TO before me this 4th day of November, 1955

My commission expires June 25, 1956  
Francis Mader Notary Public.

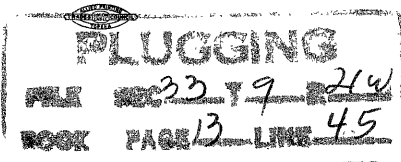

11/5/55

Herman George Kaiser - Francis Oil & Gas  
BRAGG B #1

165' E & 165' S SW NE SE  
33-9S-21W - Graham County, Ks.

Comm: 10-23-55  
Comp: 11-1-55  
Total Depth: 3890'

Casing

8 5/8" set @ 227'

Cement

135 sacks

FORMATION

DEPTH

Sand & Rock	0 - 40
Shale & sand	40 - 200
Shale	200 - 227
Shale & shells	227 - 675
Sand & shale	675 - 800
Shale & shells	800 - 1260
Sand	1260 - 1485
Red bed & shale	1485 - 1550
Red bed & sand	1550 - 1740
Anhydrite	1740 - 1780
Shale & shells	1780 - 2025
Shale & lime	2025 - 2435
Shale & shells	2435 - 2605
Shale & lime	2605 - 3515
Lime	3515 - 3563
Lime & shale	3563 - 3610
Lime	3610 - 3890

STATE OF KANSAS )  
                          ) SS  
SEDGWICK COUNTY )

I hereby certify that the above information is true and correct to the best of my knowledge.

*Herman George Kaiser*

Subscribed and sworn to before me this 4th day of November, 1955.

*Francis Mader*

My commission expires: June 25, 1956

PLUGGING  
FILE NO. 33-9-21W  
BOOK PAGE 13 LINE 45