

15-065-02571-00-00

WELL PLUGGING RECORD


STATE OF KANSAS
STATE CORPORATION COMMISSION

FORMATION PLUGGING RECORD

Give All Information Completely
Make Required Affidavit
Mail or Deliver Report to:
Conservation Division
State Corporation Commission
800 Biting Building
Wichita, Kansas

Strike out upper line
when reporting plug-
ging off formations.

NORTH

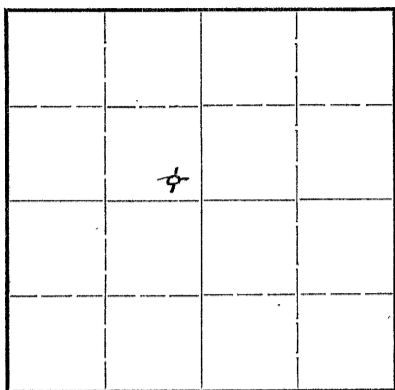

Locate well correctly on above
Section Plat

Graham County. Sec. 33 Twp. 9 Rge. (E) 21 (W)
 Location as "NE $\frac{1}{4}$ NW $\frac{1}{4}$ SW $\frac{1}{4}$ " or footage from lines SE $\frac{1}{4}$ SE $\frac{1}{4}$ NW $\frac{1}{4}$
 Lease Owner Derby Oil Company ET AL
 Lease Name Cox Well No. 1
 Office Address Wichita, Kansas
 Character of Well (completed as Oil, Gas or Dry Hole) Dry Hole
 Date well completed May 8 19 47
 Application for plugging filed By Phone To Agent May 8 19 47
 Application for plugging approved Phone By Agent May 8 19 47
 Plugging commenced May 8 19 47
 Plugging completed May 8 19 47
 Reason for abandonment of well or producing formation Not Productive
 If a producing well is abandoned, date of last production 19
 Was permission obtained from the Conservation Division or its agents before plugging was commenced? Yes

Name of Conservation Agent who supervised plugging of this well C. D. Stough
 Producing formation None Depth to top Bottom Total Depth of Well 4018 Feet
 Show depth and thickness of all water, oil and gas formations.

OIL, GAS OR WATER RECORDS

CASING RECORD

Formation	Content	From	To	Size	Put In	Pulled Out
				8 5/8	326	None

Describe in detail the manner in which the well was plugged, indicating where the mud fluid was placed and the method or methods used in introducing it into the hold. If cement or other plugs were used, state the character of same and depth placed, from _____ feet to _____ feet for each plug set.

4018' To 335' Heavy Mud
 335' To 283' Wood Plug and 15 Sacks Cement
 283' To 41' Heavy Mud
 41' To 6' Wood Plug and 10 Sacks Cement
 6' To Surface, Earth

(If additional description is necessary, use BACK of this sheet)

Correspondence regarding this well should be addressed to The Derby Oil Company
 Address Wichita, Kansas

STATE OF Kansas, COUNTY OF Sedgwick, ss.
 S. E. Banks (employee of owner) or (owner or operator) of the above-described well,
 being first duly sworn on oath, says: That I have knowledge of the facts, statements, and matters herein contained and the log of the above-described well as filed and that the same are true and correct. So help me God.

(Signature) S. E. Banks
 Wichita, Kansas (Address) 5/20/47
 MAY 20 1947

SUBSCRIBED AND SWORN to before me this 15th day of May

My commission expires July 8, 1950

Notary Public.

PLUGGING
 FILE SEC-33 T 9 R21W
 BOOK PAGE 109 LINE 5

THE DERBY OIL COMPANY
ET AL

Record of Well No. 1

Farm: Cox

Location: SE SE NW

Sec. 33 Twp. 9 Rge. 21W

Contractor: Glenn W. Peel

County: Graham

Drilling Commenced: 4-25-47

State: Kansas

Elevation: 2302

Drilling Completed: 5-8-47

CASING RECORD

8 5/8" cem. @ 326' (NEW 24#) w/150 sz. bulk cem. by Halliburton -11" hole.

DRILLERS LOG

Formation	Bottom	Formation	Bottom
Sand & Shale	0- 327		
Shale	500		
Shale & Sand	1760		
Anhydrite	1795		
Shale & Lime	3495	Lansing	3498' (-1196)
Lime	3810	Conglomerate	3806' (-1504)
Shale & Lim	3900	Arbuckle	3884' (-1582)
Lime	4018	Total Depth	4018' (-1716)

GEOLOGICAL DATA

No Shows - D&A

PLUGGING
FILE SEC 33 T 9 R 21W
BOOK PAGE 109 LINE 5

