


Give All Information Completely
Make Required Affidavit
Mail or Deliver Report to:
Conservation Division
State Corporation Commission
211 No. Broadway
Wichita, Kansas

WELL PLUGGING RECORD

Graham County, Sec. 33 Twp. 9 Rge. 21 (E) W (W)

Location as "NE/CNW/SW" or footage from lines CNE NE NW
Lease Owner American Petrofina Company of Texas
Lease Name Cox Well No. 4
Office Address Russell, Kansas
Character of Well (completed as Oil, Gas or Dry Hole)
Date well completed 19____
Application for plugging filed 19____
Application for plugging approved 19____
Plugging commenced 5-21-63 19____
Plugging completed 5-21-63 19____
Reason for abandonment of well or producing formation Depleted.

NORTH

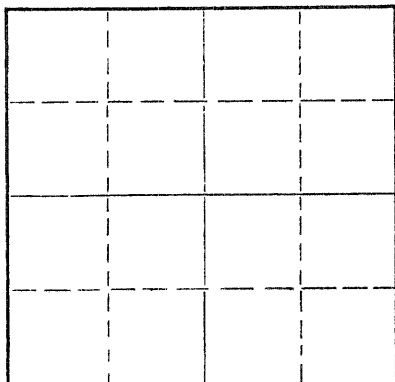

Locate well correctly on above
Section Plat

If a producing well is abandoned, date of last production 19____
Was permission obtained from the Conservation Division or its agents before plugging was commenced? yes

Name of Conservation Agent who supervised plugging of this well X W. L. Nichols
Producing formation _____ Depth to top _____ Bottom _____ Total Depth of Well 3907 Feet
Show depth and thickness of all water, oil and gas formations.

OIL, GAS OR WATER RECORDS

CASING RECORD

FORMATION	CONTENT	FROM	TO	SIZE	PUT IN	PULLED OUT
				8-5/8"	218'	None
				5-1/2"	3904'	681'

Describe in detail the manner in which the well was plugged, indicating where the mud fluid was placed and the method or methods used in introducing it into the hole. If cement or other plugs were used, state the character of same and depth placed, from _____ feet to _____ feet for each plug set.

Checked hole, sanded hole to 3900' and
dumped 5 sacks of cement @ 3900' with
dump bailer. Pumped mud to 700' and pulled
~~5' casing to 692'~~ shot casing @ 692' and
pumped 20 sacks of cement. Pulled casing
to 200' and pumped in 20 sacks of cement.
Pulled balance of casing, pumped mud to 35'
and ran 10 sacks of cement to base of cellar.

RECEIVED
STATE CORPORATION COMMISSION
6/3/63
JUN 3 1963

PLUGGING COMPLETE.

CONSERVATION DIVISION
Wichita, Kansas

(If additional description is necessary, use BACK of this sheet)
Name of Plugging Contractor KNIGHT CASING PULLING COMPANY
Address CHASE, KANSAS

STATE OF KANSAS COUNTY OF RICE, ss.
Noel J. Knight (employee of owner) or (owner/operator) of the above-described

well, being first duly sworn on oath, says: That I have knowledge of the facts, statements, and matters herein contained and the log of the above-described well as filed and that the same are true and correct. So help me God.

(Signature) Noel J. Knight
Chase, Kansas
(Address)

SUBSCRIBED AND SWORN TO before me this 29th day of May, 1963

My commission expires May 20, 1964

Milton J. Volin
Notary Public.



15-065-02997-00-00

EL HIGDONO EXPLORING COMPANY
Box # 4

C RR SW NW Sec. 33-08-22E
Graham County, Kansas

Comm. March 4, 1956
Comp. March 13, 1956
Total Depth 3905'

CASING

8 1/2" Set @ 218'
5 1/2" Set @ 307'

SHOULDER

150 Sacks
75 Sacks

FORMATION

DEPTH

Clay	0 -	30
Shale	30 -	50
Sand	50 -	110
Shale - Shells	110 -	755
Sand - Shale	755 -	1450
Shale - Shells	1450 -	1800
Anhydrite	1800 -	1840
Shale & Shells	1840 -	1915
Shale & Shells	1915 -	2050
Lime & Shale	2050 -	2235
Lime - Shale	2235 -	3205
Lime	3205 -	3265
Lime	3265 -	3525
Lime & Shale	3525 -	3555
Kansas City	3555 -	3565
Lime	3565 -	3880
Cong.	3880 -	3896
Artesian Lime	3896 -	3905

2-15-59
Casing Squeeze
Hole @ 1292
Squeezed w/ 200 SKS
Max Press 1700 #

RECEIVED
STATE CORPORATION COMMISSION

MAY 14 1963

CONSERVATION DIVISION
Wichita, Kansas

STATE OF KANSAS)
COUNTY OF SEDGWICK) SS

I hereby certify that the above information is true and correct to the best of my knowledge.

/s/ Dale Silvert

Subscribed and sworn to before me this 19th day of March, 1956.

/s/ Frances M. Miller
Notary Public

My commission expires June 25, 1956.