

STATE OF KANSAS  
STATE CORPORATION COMMISSION

WELL PLUGGING RECORD

Give All Information Completely  
Make Required Affidavit  
Mail or Deliver Report to:  
Conservation Division  
State Corporation Commission  
211 No. Broadway  
Wichita, Kansas

Graham County. Sec. 17 Twp. 9 Rge. (E) 22 (W)

Location as "NE/CNW/SW" or footage from lines SE SE SW

Lease Owner J. F. Darby Oil Company

Lease Name Brandyberry Well No. 1

Office Address 1807 Philtower Bldg., Tulsa, Okla.

Character of Well (completed as Oil, Gas or Dry Hole) Dry Hole

Date well completed 5-11-58 1958

Application for plugging filed 5-11-58 1958

Application for plugging approved 5-11-58 1958


Plugging commenced 5-11-58 1958

Plugging completed 5-11-58 1958

Reason for abandonment of well or producing formation Dry Hole

If a producing well is abandoned, date of last production None 1958

Was permission obtained from the Conservation Division or its agents before plugging was commenced? Yes

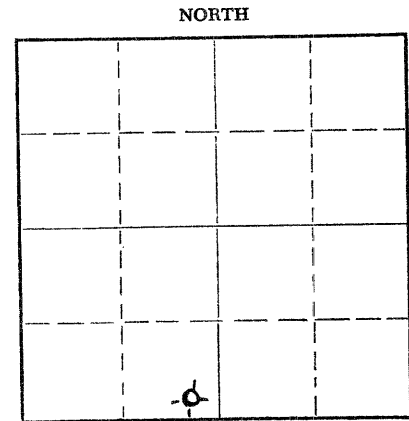

Locate well correctly on above Section Plat

Name of Conservation Agent who supervised plugging of this well A. D. Fabricius

Producing formation None Depth to top \_\_\_\_\_ Bottom \_\_\_\_\_ Total Depth of Well 4055 Feet

Show depth and thickness of all water, oil and gas formations.

OIL, GAS OR WATER RECORDS

CASING RECORD

FORMATION	CONTENT	FROM	TO	SIZE	PUT IN	PULLED OUT
<u>Topeka</u>		<u>3375'</u>		<u>8-5/8"</u>	<u>212'</u>	<u>None</u>
<u>Heebner</u>		<u>3595'</u>				
<u>Lansing</u>		<u>3630'</u>				
<u>Kansas City (Base)</u>		<u>3853'</u>				
<u>Arbuckle</u>		<u>4030'</u>				

Describe in detail the manner in which the well was plugged, indicating where the mud fluid was placed and the method or methods used in introducing it into the hole. If cement or other plugs were used, state the character of same and depth placed, from \_\_\_\_\_ feet to \_\_\_\_\_ feet for each plug set.

Filled hole with heavy mud from bottom to 500 feet.

Set wood plug and cemented w/ 1/4 sacks of cottonseed hulls and 25 sacks of cement.

Filled hole with heavy mud to 205'. Set wood plug and cemented w/ 1/4 sacks of cottonseed hulls and 15 sacks of cement. Filled hole with heavy mud to 40'.

Set wood plug and cemented with 10 sacks of cement.

RECEIVED  
STATE CORPORATION COMMISSION  
5/24/58  
MAY 24 1958

CONSERVATION DIVISION  
Wichita

(If additional description is necessary, use BACK of this sheet)

Name of Plugging Contractor Iron Drilling Company

Address 1206 Philtower Bldg., Tulsa, Okla.

STATE OF Oklahoma, COUNTY OF Tulsa, ss.  
J. L. Stackpole (employee of owner) or (owner or operator) of the above-described

well, being first duly sworn on oath, says: That I have knowledge of the facts, statements, and matters herein contained and the log of the above-described well as filed and that the same are true and correct. So help me God.

(Signature) J. L. Stackpole  
1206 Philtower Bldg., Tulsa, Okla.  
(Address)

SUBSCRIBED AND SWORN TO before me this 19 day of May, 19 58

B. Mihal

Notary Public.

My commission expires Feb. 28, 1960

PLUGGING  
FILE SEC. 17 T. 9 R. 22W  
BOOK PAGE 100 LINE 30

DRILLING RECORD

Brandyberry No. 1  
SE SE SW Sec. 17-9-22W  
Graham County, Kansas

212' - 8-5/8" OD Casing  
cemented w/ 150 sack

No Oil String - Dry Hole

Work Commenced: 4/29/58  
Drilling Commenced: 4/30/58  
Drilling Completed: 5/10/58  
Work Completed: 5/12/58

WELL LOG

Surface Soil	0	-	215
Blue Shale	215	-	520
Shale & Shells	520	-	1200
Shale & Sand	1200	-	1300
Shale & Shells	1300	-	1380
Sand	1380	-	1640
Lime Shells & Red Bed	1640	-	1912
Anhydrite	1912	-	1950
Shale & Shells	1950	-	2300
Shale & Lime	2300	-	2615
Shale	2615	-	2655
Lime & Shale	2655	-	3233
Lime	3233	-	3841
Lime & Chert	3841	-	3965
Conglomerate	3965	-	4030
Arbuckle	4030	-	4050
Lime	4050	-	4055 T.D.

CERTIFICATION

State of Oklahoma, County of Tulsa, SS

I, J. L. Stackpole, Employee of Iron Drilling Company, certify that the accompanying is a true and correct log of the above described well.

J. L. Stackpole

Subscribed to and Sworn before me this 19th day of May, 1958

J. Michal  
Notary Public

My Commission expires Feb. 28, 1960

**RECEIVED**  
STATE CORPORATION COMMISSION

MAY 24 1958

DIVISION

**PLUGGING**  
WELL SEC 17 9 22W  
BOOK PAGE 100 LINE 30