


WELL PLUGGING RECORD

Give All Information Completely
Make Required Affidavit
Mail or Deliver Report to:
Conservation Division
State Corporation Commission
800 Bitting Building
Wichita, Kansas

NORTH

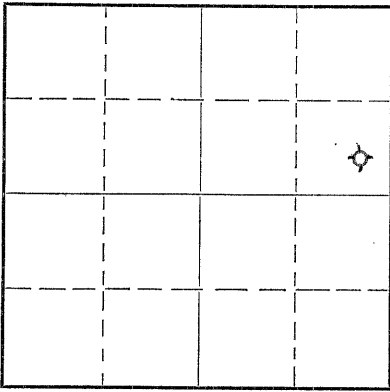

Locate well correctly on above
Section Plat

Graham County. Sec. 23 Twp. 9 Rge. 22 (E) W (W)
Location as "NE/CNW 1/4 SW 1/4" or footage from lines SE SE NE
Lease Owner C-G Drilling Co. Inc.
Lease Name Zvolanek Well No. I
Office Address 206 Union Natl Bank Bldg.
Character of Well (completed as Oil, Gas or Dry Hole) Dry Hole
Date well completed July 11 19 50
Application for plugging filed July 11 19 50
Application for plugging approved July 11 19 50
Plugging commenced July 11 19 50
Plugging completed July 11 19 50
Reason for abandonment of well or producing formation Too low structurally
to produce.
If a producing well is abandoned, date of last production _____ 19 ____
Was permission obtained from the Conservation Division or its agents before plugging was commenced? Yes

Name of Conservation Agent who supervised plugging of this well Eldon Petty, Hays, Kansas
Producing formation _____ Depth to top _____ Bottom _____ Total Depth of Well _____ Feet
Show depth and thickness of all water, oil and gas formations.

OIL, GAS OR WATER RECORDS

CASING RECORD

Formation	Content	From	To	Size	Put In	Pulled Out
				8-5/8" (28#)	245.12'	

Describe in detail the manner in which the well was plugged, indicating where the mud fluid was placed and the method or methods used in introducing it into the hole. If cement or other plugs were used, state the character of same and depth placed, from _____ feet to _____ feet for each plug set.

Filled with drilling mud to 246'. Drove plug to 245'. Put in 15 sacks cement then pumped full of mud 25' from top of hole. Drove plug down to 25' then filled to top with 10 sacks of cement.

7/15/50

(If additional description is necessary, use BACK of this sheet)

Correspondence regarding this well should be addressed to C-G Drilling Co. Inc.
Address 206 Union Natl Bank Bldg., Wichita, Kansas

STATE OF KANSAS, COUNTY OF SEDGWICK, ss.
R. A. Cook (employee or owner) or (owner or operator) of the above-described well,

being first duly sworn on oath, says: That I have knowledge of the facts, statements, and matters herein contained and the log of the above-described well as filed and that the same are true and correct. So help me God.

(Signature) R. A. Cook

206 Union Natl Bank Bldg.
(Address)

SUBSCRIBED AND SWORN TO before me this 11th day of July, 19 50

My commission expires June 25, 1951

Notary Public. Wicky Lutz

PLUGGING
FILE SEC 23 T 9 R 22
BOOK PAGE 16 LINE 4

15-265-00147-00-00

CONTRACTOR S WELL LOG

Operator C-G Drilling Co. Inc. Farm Name Zvolanek #1
 Location SE SE NE Sec. 23-9-22W
 Pool Name WC County Graham State Kansas
 Commencement Date 6-28-50 Completion Date 7-11-50

Log of Well

Elevation 2319 R. B
 All Measurements from the top of rotary bushing.

FROM	DEPTH TO	FORMATION	DEVIATION FROM VERTICAL	REMARKS:
0	245			
245	705	Shale & Shells		
705	790	Sand		
790	1335	Shale, Sand & Shells		
1335	1515	Sand	1500' - 0°	
1515	1560	Sand		
1560	1680	Shale Sand		
1680	1835	Shale & Redbed	1750' - 0°	
1835	1840	Anhydrite		
1840	1865	Anhydrite		
1865	2080	Shale & Shells		
2080	2240	Shale & Shells		
2240	2335	Shale Lime	2250' - 0°	
2335	2470	Shale & Lime		
2470	2575	Shale & Lime		
2575	2655	Shale & Lime		
2655	2770	Shale & Lime		
2770	2900	Shale & Lime		
2900	2965	Shale & Lime		
2965	3065	Shale & Lime	3000' - 0°	
3065	3165	Shale & Lime		
3165	3250	Shale & Lime		
3250	3325	Shale & Lime	3250' - 0°	
3325	3415	Shale & Lime		
3415	3458	Shale-Lime		
3458	3500	Shale-Lime		
3500	3550	Lime		
3550	3609	Lime		
3609	3660	Lime		
3660	3700	Lime		
3700	3770	Lime		
3770	3855	Lime		
3900	3995	Lime		

RECORDED
 JUL 15 1950
 STATE DEPARTMENT OF REVENUE
 COMMISSIONER
 KANSAS

CASING LEFT IN HOLE AFTER COMPLETION

Ran 245.12' (8 jts.) 8-5/8" OD Casing.

STATE OF KANSAS, COUNTY OF SEDGWICK) ss.

The undersigned certifies that to the best of his knowledge and belief, the above facts are true and correct.

C-G DRILLING CO, Inc.
 By R. A. Cook, President

Subscribed and sworn to before me this 13th day of July, 1950.

Richard L. Smith
 Notary Public

My commission expires:
 June 25, 1951

PLUGGING
 FILE SEC 23 T 9 R 22W
 BOOK PAGE 16 LINE 4