


STATE OF KANSAS  
STATE CORPORATION COMMISSION  
Give All Information Completely  
Make Required Affidavit  
Mail or Deliver Report to:  
Conservation Division  
State Corporation Commission  
800 Bittling Building  
Wichita, Kansas

WELL PLUGGING RECORD

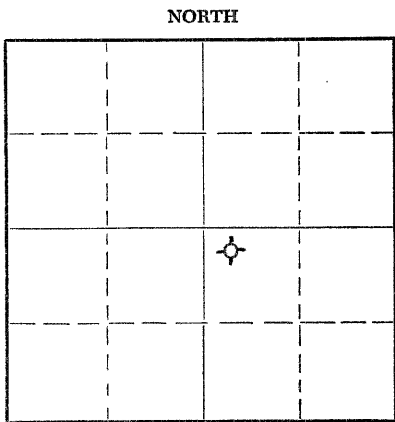

Graham County. Sec. 24 Twp. 9S Rge. 22 (X) W (W)  
Location as "NE/CNW/SW" or footage from lines NW NW SE  
Lease Owner D. G. Hansen  
Lease Name Kern Well No. 1  
Office Address Logan, Kansas  
Character of Well (completed as Oil, Gas or Dry Hole) Dry Hole  
Date well completed 7-8 19 53  
Application for plugging filed 7-8 19 53  
Application for plugging approved 7-8 19 53  
Plugging commenced 7-8 19 53  
Plugging completed 7-8 19 53  
Reason for abandonment of well or producing formation Too low structurally

If a producing well is abandoned, date of last production -- 19  
Was permission obtained from the Conservation Division or its agents before plugging was commenced? Yes

Name of Conservation Agent who supervised plugging of this well Eldon Petty, Hays, Kansas  
Producing formation -- Depth to top -- Bottom -- Total Depth of Well 3991 Feet  
Show depth and thickness of all water, oil and gas formations.

OIL, GAS OR WATER RECORDS					CASING RECORD	
FORMATION	CONTENT	FROM	TO	SIZE	PUT IN	PULLED OUT
				8-5/8"	164.38	

Describe in detail the manner in which the well was plugged, indicating where the mud fluid was placed and the method or methods used in introducing it into the hole. If cement or other plugs were used, state the character of same and depth placed, from feet to feet for each plug set.

Filled hole with heavy mud to 155'; set solid plug; 1/2 sack hulls, 15 sacks cement. Filled hole with heavy mud to 40'; set plug then filled to top with 10 sacks cement 1/2 sack hulls.

(If additional description is necessary, use BACK of this sheet)  
Name of Plugging Contractor C-G Drilling Co.  
Address 544 Petroleum Building, Wichita, Kansas

STATE OF KANSAS, COUNTY OF SEDGWICK, ss.  
Vicky Jacobs (employee of owner) or (owner or operator) of the above-described well, being first duly sworn on oath, says: That I have knowledge of the facts, statements, and matters herein contained and the log of the above-described well as filed and that the same are true and correct. So help me God.

(Signature) Vicky Jacobs  
544 Petroleum Bldg., Wichita, Kansas  
(Address)

SUBSCRIBED AND SWORN to before me this 9th day of July, 19 53

My commission expires June 17, 1957  
Barbara [Signature] Notary Public.

PLUGGING  
FILE SEC 24 T 9 R 22W  
BOOK PAGE 114 LINE 10

JUL 15 1953  
7/15/53  
CONSERVATION DIVISION

15-065-00372-0000

## CONTRACTOR'S WELL LOG

OPERATOR D. G. Hansen FARM NAME Kern No. 1  
 LOCATION NW NW SE, Sec. 24-9s-22W  
 POOL NAME \_\_\_\_\_ COUNTY Graham STATE Kansas  
 COMMENCEMENT DATE June 29, 1953 COMPLETION DATE July 8, 1953

## LOG OF WELL

Elevation: 2355 R.B.

All measurements from the top of rotary bushing.

FROM	TO	FORMATION	DEVIATION FROM VERTICAL	REMARKS:
0	164	Sand-Shale		
164	1015	Sand-Shale		
1015	1080	Sand		
1080	1400	Shale-Sand-Shells		
1400	1465	Sand		
1465	1620	Sand	0°-1500'	
1620	1835	Shale-Shells-Pyrite		
1835	1878	Redbed		
1878	1915	Anhydrite		
1915	2150	Shale	0°-2000'	
2150	2375	Shale		
2375	2580	Shale-Shells	0°-2500'	
2580	2725	Lime-Shale		
2725	2885	Lime-Shale		
2885	3005	Lime-Shale	0°-3000'	
3005	3105	Lime-Shale		
3105	3225	Lime-Shale		
3225	3265	Lime-Shale		
3265	3310	Lime-Shale		
3310	3400	Lime-Shale		
3400	3454	Lime-Shale		
3454	3560	Lime-Shale	0°-3500'	
3560	3615	Lime		
3615	3685	Lime-Shale		
3685	3736	Lime		
3736	3790	Lime		DST 3771-90'
3790	3870	Lime-Shale		
3870	3925	Lime-Shale		
3925	3991	Cherty Lime-Shale		

## CASING LEFT IN HOLE AFTER COMPLETION

Ran 164.38 (5 Jts) 8-5/8" Surface Casing.

STATE OF KANSAS }  
 COUNTY OF SEDGWICK } ss.

The undersigned certifies that to the best of her knowledge and belief, the above facts are true and correct.

C-G DRILLING CO.


By

Vicky Jacobs  
 Office Mgr.

Subscribed and sworn to before me this 9th day of July, 1953.

My commission expires: 6/17/57

Barbara Donaldson  
 Notary Public

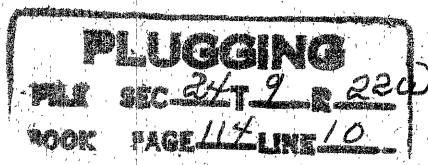

CONSERVATION DIVISION