

STATE OF KANSAS
STATE CORPORATION COMMISSION

Give All Information Completely
Make Required Affidavit
Mail or Deliver Report to:
Conservation Division
State Corporation Commission
800 Bitting Building
Wichita, Kansas

WELL PLUGGING RECORD

Graham County. Sec. 24 Twp. 9 Rge. 22 (E) W (W)

Location as "NE/CNW/SW" or footage from lines NE NE NW

Lease Owner C-G Drilling Co.

Lease Name Mills Well No. 1

Office Address 544 Petroleum Building

Character of Well (completed as Oil, Gas or Dry Hole) Dry Hole

Date well completed 5-26 1953

Application for plugging filed 5-26 1953

Application for plugging approved 5-26 1953


Plugging commenced 5-27 1953

Plugging completed 5-27 1953

Reason for abandonment of well or producing formation Too low structurally

If a producing well is abandoned, date of last production -- 19--

Was permission obtained from the Conservation Division or its agents before plugging was commenced? Yes

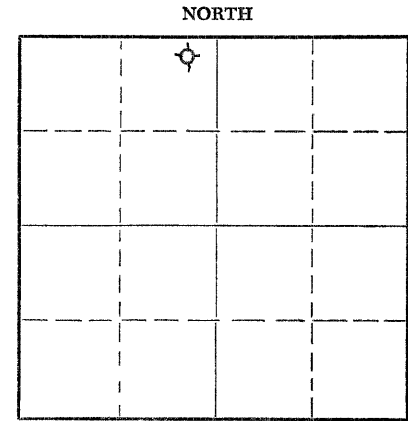

Locate well correctly on above Section Plat

Name of Conservation Agent who supervised plugging of this well Eldon Petty, Hays, Kansas

Producing formation -- Depth to top -- Bottom -- Total Depth of Well -- Feet

Show depth and thickness of all water, oil and gas formations.

OIL, GAS OR WATER RECORDS

CASING RECORD

FORMATION	CONTENT	FROM	TO	SIZE	PUT IN	PULLED OUT
				8-5/8"	160.04'	

Describe in detail the manner in which the well was plugged, indicating where the mud fluid was placed and the method or methods used in introducing it into the hole. If cement or other plugs were used, state the character of same and depth placed, from -- feet to -- feet for each plug set.

Filled hole with mud to 170'; set plug; 1/2 sack hulls, 15 sacks cement, filled hole with mud to 40'; set plug then filled to top with 10 sacks cement 1/2 sack hulls

RECEIVED
STATE CORPORATION COMMISSION
6/1/53
JUL 1 1953

CONSERVATION DIVISION
WICHITA, KANSAS

(If additional description is necessary, use BACK of this sheet)

Name of Plugging Contractor C-G Drilling Co.

Address 544 Petroleum Building, Wichita, Kansas

STATE OF KANSAS, COUNTY OF SEDGWICK, ss.
Vicky Jacobs (employee of owner) or (~~SWORN AGENT~~) of the above-described

well, being first duly sworn on oath, says: That I have knowledge of the facts, statements, and matters herein contained and the log of the above-described well as filed and that the same are true and correct. So help me God.

(Signature) Vicky Jacobs
544 Petroleum Building
(Address)

SUBSCRIBED AND SWORN TO before me this 29th day of May, 1953

Marilyn Schmidt
Notary Public.

My commission expires 11/21/55

PLUGGING
FILE SEC 24 T 9 R 22W
BOOK PAGE 104 LINE 17

CONTRACTOR'S WELL LOG

OPERATOR C-G DRILLING CO. FARM NAME Mills #1
 LOCATION NE NE NW Sec. 24-9-22W
 POOL NAME _____ COUNTY Graham STATE Kansas
 COMMENCEMENT DATE May 15, 1953 COMPLETION DATE May 26, 1953

LOG OF WELL

Elevation: 2302 R. B.
 All measurements from the top of rotary bushing.

FROM	TO	FORMATION	DEVIATION FROM VERTICAL	REMARKS:
0	165	Sand-Shale		
165	1150	Sand-Shale		
1150	1790	Sand-Shale	0° - 1500'	
1790	1820	Anhydrite		
1820	1830	Anhydrite		
1830	2320	Shale-Shells	0° - 2000'	
2320	2405	Shale-Shells		
2405	2630	Lime-Shale	0° - 2500'	
2630	2835	Lime-Shale		
2835	2900	Lime-Shale		
2900	3060	Lime-Shale	0° - 3000'	
3060	3230	Lime-Shale		
3230	3285	Lime-Shale		
3285	3358	Lime-Shale		
3358	3455	Lime-Shale		
3455	3505	Lime-Shale	0° - 3500'	
3505	3542	Lime-Shale		
3542	3587	Lime-Shale		DST - 3581-3587'
3587	3628	Lime		
3628	3675	Lime-Shale		
3675	3710	Lime-Shale		
3710	3736	Lime-Shale		DST - 3722-3736
3736	3750	Lime-Shale		
3750	3818	Congl		
3818	3840	Congl		
3840	3878	Chert-Shale		
3878	3952	Chert-Shale		
3952	3955	Lime-Shale		

RECEIVED
 CORPORATION COMMISSION
 JUN 7 1953
 CONSERVATION DIVISION
 WICHITA, KANSAS

CASING LEFT IN HOLE
 AFTER COMPLETION

Ran 165.04' of 8 5/8" Surface Casing

STATE OF KANSAS, COUNTY OF SEDGWICK) ss.

The undersigned certifies that to the best of her knowledge and belief, the above facts are true and correct.

C-G DRILLING CO.

By Vicky Jacobs

Subscribed and sworn to before me this 29th day of May, 1953.

My commission expires:

Marilyn Schmidt
 Notary Public

PLUGGING
 FILE SEC 24 T 9 R 22W
 BOOK PAGE 104 LINE 17