


Give All Information Completely
Make Required Affidavit
Mail or Deliver Report to:
Conservation Division
State Corporation Commission
800 Bittig Building
Wichita, Kansas

WELL PLUGGING RECORD

NORTH

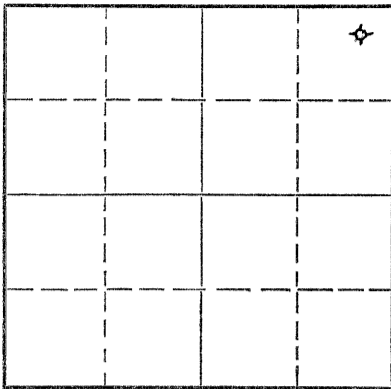

Locate well correctly on above Section Plat

GRAHAM County. Sec. 24 Twp. 9 Rge. 22 (E) W (W)
Location as "NE/CNW%SW%" or footage from lines NE NE NE
Lease Owner D. G. HANSEN
Lease Name MILLS Well No. 1
Office Address Logan, Kansas
Character of Well (completed as Oil, Gas or Dry Hole) Dry Hole
Date well completed 7-26 19 53
Application for plugging filed 7-26 19 53
Application for plugging approved 7-26 19 53
Plugging commenced 7-26 19 53
Plugging completed 7-26 19 53
Reason for abandonment of well or producing formation Too low structurally

If a producing well is abandoned, date of last production -- 19 --
Was permission obtained from the Conservation Division or its agents before plugging was commenced? Yes

Name of Conservation Agent who supervised plugging of this well Eldon Petty, Hays, Kansas
Producing formation -- Depth to top -- Bottom -- Total Depth of Well 3910 Feet
Show depth and thickness of all water, oil and gas formations.

OIL, GAS OR WATER RECORDS

CASING RECORD

FORMATION	CONTENT	FROM	TO	SIZE	PUT IN	PULLED OUT
				8-5/8"	163.85	

Describe in detail the manner in which the well was plugged, indicating where the mud fluid was placed and the method or methods used in introducing it into the hole. If cement or other plugs were used, state the character of same and depth placed, from _____ feet to _____ feet for each plug set.

Filled hole with mud to 160'; set plug; 1/2 sacks hulls, 15 sacks cement. Filled hole with mud to 40'; set plug then filled to top with 10 sacks cement 1/2 sack hulls

(If additional description is necessary, use BACK of this sheet)
Name of Plugging Contractor C-G DRILLING CO.
Address 544 Petroleum Building, Wichita, Kansas

STATE OF KANSAS, COUNTY OF SEDGWICK, ss. Vicky Jacobs (employee of owner) or (owner or operator) of the above-described well, being first duly sworn on oath, says: That I have knowledge of the facts, statements, and matters herein contained and the log of the above-described well as filed and that the same are true and correct. So help me God.

(Signature) Vicky Jacobs
544 Petroleum Bldg., Wichita, Kansas Office Mgr.
(Address)

SUBSCRIBED AND SWORN TO before me this 28th day of July, 1953

Barbara Donaldson
Notary Public.

My commission expires June 17, 1957

INDEXING
24 9 220
118 3

7/29/53
CONS

15-065-02174-00-00

CONTRACTOR'S WELL LOG

OPERATOR D. G. HANSEN FARM NAME MILLS NO. 1
 LOCATION NE NE NE SEC. 24-9-22W
 POOL NAME _____ COUNTY GRAHAM STATE KANSAS
 COMMENCEMENT DATE 7-18-53 COMPLETION DATE 7-26-53

LOG OF WELL

Elevation: 2311 R.B.

All measurements from the top of rotary bushing.

FROM	TO	FORMATION	DEVIATION FROM VERTICAL	REMARKS:
0	164	Shale-sand		
164	1010	Sand		
1010	1075	Sand		
1075	1360	Shale-Shells		
1360	1580	Sand	0° - 1500'	
1580	1809	Shale-Redbed		
1809	1848	Anhydrite		
1848	2010	Shale-Shells	0° - 2000'	
2010	2400	Lime-Shale		
2400	2565	Lime-Shale	0° - 2500'	
2565	2670	Shale-Lime		
2670	2860	Lime-Shale		
2860	2975	Lime-Shale		
2975	3100	Lime-Shale	0° - 3000'	
3100	3200	Lime-Shale		
3200	3310	Lime-Shale		
3310	3415	Lime-Shale		
3415	3510	Lime-Shale	0° - 3500'	
3510	3546	Lime		
3546	3610	Lime-Shale		
3610	3675	Lime		
3675	3725	Lime		
3725	3782	Lime-Shale		
3782	3835	Lime		
3835	3889	Lime-Shale		
3889	3910	Lime-Shale		
3910	TD	Lime-Shale		

CASING LEFT IN HOLE AFTER COMPLETION

Ran 163.85' (5 Jts) 8-5/8" OD 24# casing.

STATE OF KANSAS, COUNTY OF SEDGWICK) ss.


The undersigned certifies that to the best of her knowledge and belief, the above facts are true and correct.

C-G DRILLING CO.

By Vicky Jacobs

Subscribed and sworn to before me this 28th day of July, 1953.

My commission expires: June 17, 1957

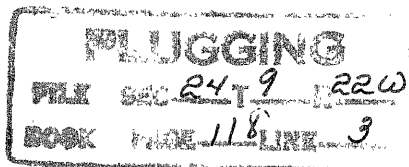Barbara Donaldson
Notary PublicRECEIVED
STATE CORPORATION COMMISSION

JUL 28 1953

CONSERVATION