


STATE OF KANSAS  
STATE CORPORATION COMMISSION

WELL PLUGGING RECORD

Give All Information Completely  
Make Required Affidavit  
Mail or Deliver Report to  
Conservation Division  
State Corporation Comm.  
245 North Water  
Wichita, KS 67202

Graham County, Sec. 26 Twp. 9 Rge. 22 ~~EW~~  
Location as "NE/CNW $\frac{1}{4}$ SW $\frac{1}{4}$ " or footage from lines  
NE SE SW

Lease Owner Collins & Collins Oil Company #8722  
Lease Name Barber-B Well No. #3  
Office Address 1007 Cody - Suite A, Hays, Kansas 67601  
Character of Well (Completed as Oil, Gas or Dry Hole)  
Oil

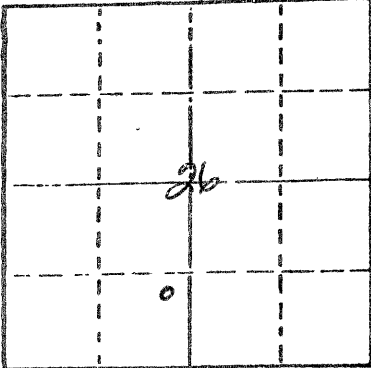

Locate well correctly on above Section Plot

Date Well completed 9-28 1983  
Application for plugging filed 6-27 1983  
Application for plugging approved 8-10 1983  
Plugging commenced 8-17 1983  
Plugging completed 8-17 1983

Reason for abandonment of well or producing formation  
Ran dry

If a producing well is abandoned, date of last production  
19

Was permission obtained from the Conservation Division or  
its agents before plugging was commenced? Yes

Name of Conservation Agent who supervised plugging of this well Carl Goodrow  
Producing formation Lansing KC Depth to top 3564 Bottom 3574 Total Depth of Well 3774  
Show depth and thickness of all water, oil and gas formations.

OIL, GAS OR WATER RECORDS

CASING RECORD

FORMATION	CONTENT	FROM	TO	SIZE	PUT IN	PULLED OUT
Surface				8 5/8"	233'	-0-
Production				5 1/2"	3917'	-0-

Describe in detail the manner in which the well was plugged, indicating where the mud fluid was placed and the method or methods used in introducing it into the hold. If cement or other plugs were used, state the character of same and depth placed, from feet to feet for each plug set.

350 sks cement with 2 sks hulls down 5 1/2" casing at 600# max pressure

(If additional description is necessary, use BACK of this sheet)


Name of Plugging Contractor B-J Oil Company #5465

STATE OF KANSAS COUNTY OF ELLIS, ss.

John B. Collins (employee of owner) or (owner or operator) of the above-described well, being first duly sworn on oath, says: That I have knowledge of the facts, statements, and matters herein contained and the log of the above-described well as filed and that the same are true and correct. So help me God.

(Signature) By: John B. Collins  
Collins & Collins Oil Company  
1007 Cody - Suite A, Hays, Kansas 67601  
(Address)

SUBSCRIBED AND SWORN TO before me this 13th day of September, 1983

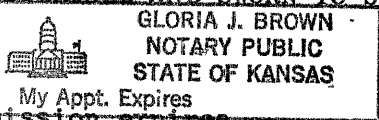

My commission expires 7-15-84

Gloria Brown Notary Public.

RECEIVED  
STATE CORPORATION COMMISSION  
9/14/83  
SEP 14 1983

CONSERVATION DIVISION  
Wichita, Kansas

13-483-2627, Russell, Kansas  
 Phone 316-793-5861, Great Bend, Kansas

Phone Plainville 913-434-2812  
 Phone Kiowa 316-825-4618

OLD

# ALLIED CEMENTING CO., INC. No 35407

Home Office P. O. Box 31 Russell, Kansas 67665

Date <u>8-17-83</u>	Sec. <u>26</u>	Twp. <u>9<sup>s</sup></u>	Range <u>22<sup>w</sup></u>	Called Out <u>7:00 A.M.</u>	On Location <u>1:00 P.M.</u>	Job Start <u>1:15 P.M.</u>	Finish <u>1:45 P.M.</u>
Case <u>Barber</u>	Well No. <u>"B"-3</u>		Location <u>Redline #13equr Rd 2w 3/4 N 3/4 W</u>		County <u>Graham</u>		State <u>Ks</u>
Contractor <u>C. Tools</u>				Owner <u>Jane</u>			
Type Job <u>D &amp; A</u>				To Allied Cementing Co., Inc. You are hereby requested to rent cementing equipment and furnish cementer and helper to assist owner or contractor to do work as listed.			
Cable Size <u>2 1/8"</u>		T.D. <u>3917'</u>		Charge To <u>J. B. Collins</u>			
Cable Size <u>5 1/2"</u>		Depth		Street <u>1007 Coody, Suite A</u>			
Cable Size <u>8 3/8"</u>		Depth <u>233'</u>		City <u>Hays</u> State <u>Ks 67601</u>			
Drill Pipe		Depth		The above was done to satisfaction and supervision of owner agent or contractor.			
Cement Left in Csg.		Shoe Joint		Purchase Order No.			
Cement Max. <u>600#</u>		Minimum		X <u>Vernon Chard</u>			
Cement Line		Displace		<b>CEMENT</b>			

### EQUIPMENT

Pumptrk	No	Cementor	<u>Gary H.</u>
	<u>80</u>	Helper	
Pumptrk	No	Cementor	<u>Mike S.</u>
		Helper	
Drktrk	<u>#156</u>	Driver	
Drktrk		Driver	

Amount Ordered	<u>350 sks 50/50 plus 6 bags</u>	
Consisting of	<u>2 sks Pulls</u>	
Common	<u>175 sks @ 5.00/sk.</u>	<u>875.00</u>
Poz. Mix	<u>175 sks @ 2.10/sk.</u>	<u>367.50</u>
Gel.	<u>21 sks @ 7.25/sk.</u>	<u>152.25</u>
Chloride		
Quickset		
Pulls -	<u>2 sks @ 14.00/sk.</u>	<u>28.00</u>

EPH of Job		
Reference:	<u>#10 Pumptrk - Day</u>	<u>\$200.00</u>
	<u>#14 Mileage</u>	<u>N/C</u>
	Sub Total	<u>\$200.00</u>
	Tax	
	Total	

	Sales Tax	
Handling	<u>¢90 + /sk. (373 sks)</u>	<u>335.70</u>
Mileage	<u>¢66 + /mi. (26 mi.)</u>	<u>273.49</u>
	Sub Total	<u>\$2031.94</u>
	Total	

Remarks: Down 5 1/2" csg; mixed pulls with the cement and shut in @ 150# of pressure.

Floating Equipment Thanks