


STATE OF KANSAS  
STATE CORPORATION COMMISSION

Give All Information Completely  
Make Required Affidavit  
Mail or Deliver Report to:  
Conservation Division  
State Corporation Commission  
800 Bittling Building  
Wichita, Kansas

WELL PLUGGING RECORD

NORTH

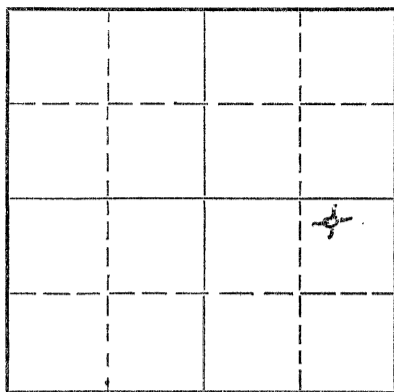

Locate well correctly on above  
Section Plat

Graham County. Sec. 26 Twp. 9S Rge. (E) 22 (W)  
Location as "NE/CNW/SW/" or footage from lines NW NE SE  
Lease Owner Peel\*Hardman  
Lease Name Desair Well No. 3  
Office Address P.O. Box 359, Hoisington, Kansas  
Character of Well (completed as Oil, Gas or Dry Hole) Dry Hole  
Date well completed July 15 19 54  
Application for plugging filed July 15 19 54  
Application for plugging approved July 15 19 54  
Plugging commenced July 15 19 54  
Plugging completed July 15 19 54  
Reason for abandonment of well or producing formation Dry Hole

If a producing well is abandoned, date of last production \_\_\_\_\_ 19\_\_\_\_  
Was permission obtained from the Conservation Division or its agents before plugging was commenced? Yes

Name of Conservation Agent who supervised plugging of this well Eldon Petty  
Producing formation \_\_\_\_\_ Depth to top \_\_\_\_\_ Bottom \_\_\_\_\_ Total Depth of Well 3805 Feet  
Show depth and thickness of all water, oil and gas formations.

OIL, GAS OR WATER RECORDS

CASING RECORD

FORMATION	CONTENT	FROM	TO	SIZE	PUT IN	PULLED OUT
		0	166	8 5/8"	166	None

Describe in detail the manner in which the well was plugged, indicating where the mud fluid was placed and the method or methods used in introducing it into the hole. If cement or other plugs were used, state the character of same and depth placed, from \_\_\_\_\_ feet to \_\_\_\_\_ feet for each plug set.

From 3805' to 161 1/2' - Heavy rotary mud  
" 161 1/2' to 160' - Wooden plug  
" 160' to 114' - 15 sacks cement, 1/2 sack hulls  
" 114' to 41 1/2' - Heavy rotary mud  
" 41 1/2' to 40' - Wooden plug  
" 40' to 6' - 10 sacks cement, 1/2 sack hulls  
" 6' to Surface - cellar

7/21/54

(If additional description is necessary, use BACK of this sheet)

Name of Plugging Contractor Glenn W. Peel  
Address P.O. Box 359, Hoisington, Kansas

KANSAS

STATE OF \_\_\_\_\_, COUNTY OF BARTON, ss.  
Glenn W. Peel (employee of owner) or (~~owner or operator~~) of the above-described well, being first duly sworn on oath, says: That I have knowledge of the facts, statements, and matters herein contained and the log of the above-described well as filed and that the same are true and correct. So help me God. GLENN W. PEEL

(Signature) BY: [Signature]  
P. O. Box 359, Hoisington, Kansas  
(Address)

SUBSCRIBED AND SWORN TO before me this 20<sup>th</sup> day of July, 19 54

My commission expires June 4, 1955  
[Signature] Notary Public.

PLUGGING  
FILE SEC 26 T 9 R 22W  
BOOK PAGE 50 LINE 11

15-065-00399-00-00

DRILLERS' LOG

Company: Peel-Hardman

NW NE SE

Farm Name: Desair Well No. 3

Sec. 26, Twp. 9S, Rge. 22W,

Total Depth: 3805'

County: Graham,  
County

Comm: 7-7-54; Comp.: 7-15-54

Elevation:

Contractor: Glenn W. Peel

Production: Dry

Casing: 8 5/8" 166' cem.

FIGURES BELOW INDICATE BOTTOM OF FORMATION

Top soil & post rock	-0-	40
Shale & shells		168
Shale		1035
Shale & sand		1635
Shale		1860
Anhydrite		1890
Shale		2135
Shale & lime		2695
Lime		3805
Total Depth		3805

This is to certify that the above information is to the best of our knowledge, true & correct.

GLENN W. PEEL

BY: *Glenn W. Peel*

SUBSCRIBED AND SWORN to before me this 20<sup>th</sup> day of July, 1954.

My commission expires: June 4, 1955

*Marian M. Hester*  
Notary Public

**PLUGGING**  
PLM SEC 26 T 9 R 22W  
BOOK PAGE 50 LINE 11