


STATE OF KANSAS
STATE CORPORATION COMMISSION

Form CP-4

Give All Information Completely
Make Required Affidavit
Mail or Deliver Report to:
Conservation Division
State Corporation Commission
P. O. Box 17027
Wichita, Kansas 67217
NORTH

WELL PLUGGING RECORD

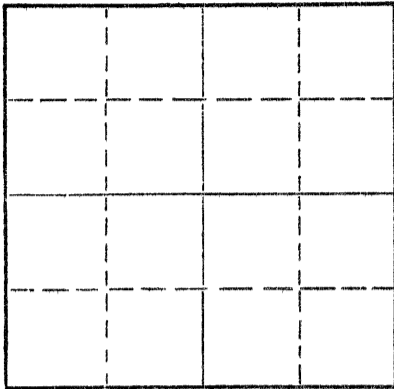

Locate well correctly on above
Section Plat

Graham County, Sec. 27 Twp. 9 Rge. 22W (E) (W)
Location as "NE/CNW/SW" or footage from lines 150' NW SW NE
Lease Owner Chief Drilling Co., Inc. & P-S Petroleum Co.
Lease Name Christine Barber Well No. 1
Office Address 905 Century Plaza, Wichita, Kansas 67202
Character of Well (completed as Oil, Gas or Dry Hole) Dry Hole
Date well completed 6/3/74 19
Application for plugging filed 6/3/74 19
Application for plugging approved 6/3/74 19
Plugging commenced 6/3/74 19
Plugging completed 6/3/74 19
Reason for abandonment of well or producing formation

If a producing well is abandoned, date of last production 19
Was permission obtained from the Conservation Division or its agents before plugging was commenced? Yes

Name of Conservation Agent who supervised plugging of this well Bill Nichols
Producing formation Depth to top Bottom Total Depth of Well 3800 Feet
Show depth and thickness of all water, oil and gas formations.

OIL, GAS OR WATER RECORDS

CASING RECORD

| FORMATION | CONTENT | FROM | TO | SIZE | PUT IN | PULLED OUT |
|-----------|---------|------|------|--------|--------|------------|
| | | 0 | 253' | 8 5/8" | | |
| | | | | | | |
| | | | | | | |
| | | | | | | |
| | | | | | | |
| | | | | | | |
| | | | | | | |
| | | | | | | |
| | | | | | | |

Describe in detail the manner in which the well was plugged, indicating where the mud fluid was placed and the method or methods used in introducing it into the hole. If cement or other plugs were used, state the character of same and depth placed, from feet to feet for each plug set.

Plugged through drill pipe @ 950' w/70 sacks cement.
Plugged through drill pipe @ 275' w/20 sacks cement.
Plugged through drill pipe @ 40' w/10 sacks cement.

RECEIVED
STATE CORPORATION COMMISSION
6/17/74
JUN 19 1974
CONSERVATION DIVISION
Wichita, Kansas

(If additional description is necessary, use BACK of this sheet)
Name of Plugging Contractor Chief Drilling Co., Inc.
Address Suite 905 Century Plaza, Wichita, Kansas 67202

STATE OF KANSAS, COUNTY OF SEDGWICK, ss.
Jim Robinson (employee of owner) or (owner or operator) of the above-described well, being first duly sworn on oath, says: That I have knowledge of the facts, statements, and matters herein contained and the log of the above-described well as filed and that the same are true and correct. So help me God

(Signature) Jim Robinson

905 Century Plaza, Wichita, Kansas 67202
(Address)

SUBSCRIBED AND SWORN TO before me this 4th day of June, 1974

My commission expires August 5, 1975

Virginia S. Fabian, Notary Public.

15-065-20679-00-00

WELL LOG

CHIEF DRILLING CO., INC. &
P-S PETROLEUM CO.
Suite 905 Century Plaza
Wichita, Kansas 67202

#1 CHRISTINE BARBER
150' NW SE NE Sec. 27-9-22W
Graham County, Kansas

CONTRACTOR: Chief Drilling Co., Inc.
CASING RECORD: Set 247' of 8 5/8" w/160
sacks Common Quick Set Cement

COMMENCED: 5/28/74
COMPLETED: 6/3/74

| <u>FORMATION</u> | <u>FROM</u> | <u>TO</u> | <u>ELEVATION</u> |
|------------------|-------------|-----------|------------------|
| Surface Hole | 0 | 256 | 2360 Gr. |
| Shale | 256 | 770 | 2362 D.F. |
| Shale & Shells | 770 | 1363 | 2365 K.B. |
| Sand | 1363 | 1600 | |
| Shale & Shells | 1600 | 1852 | |
| Anhydrite | 1852 | 1887 | |
| Shale & Shells | 1887 | 1935 | |
| Shale | 1935 | 2270 | |
| Shale & Shells | 2270 | 2650 | |
| Lime & Shale | 2650 | 2844 | |
| Shale & Shells | 2844 | 3236 | |
| Shale & Lime | 3236 | 3617 | |
| Lime | 3617 | 3800 | |
| Total Depth | 3800 | | |

| <u>FORMATION TOPS</u> | | |
|-----------------------|--------|------|
| Anhydrite | 1852 + | 513 |
| Base Anhy. | 1887 + | 478 |
| Heebner | 3554 - | 1189 |
| Toronto | 3578 - | 1213 |
| Lansing | 3592 - | 1227 |
| R.T.D. | 3800 - | 1435 |

RECEIVED
STATE CORPORATION COMMISSION

JUN 7 1974

CONSERVATION DIVISION
Wichita, Kansas

STATE OF KANSAS, COUNTY OF SEDGWICK) ss:

I hereby certify that the above is a true and correct copy of the Driller's Log of the well drilled in the 150' NW SE NW of Section 27-9-22W, Graham County, Kansas, to the best of my knowledge and belief.

CHIEF DRILLING CO., INC.

Jim Robinson
Jim Robinson, Vice President

Subscribed and sworn to before me this 6th day of June, 1974.

Virginia S. Fabian
Virginia S. Fabian, Notary Public

MY COMMISSION EXPIRES:

