

Give All Information Completely  
Make Required Affidavit  
Mail or Deliver Report to:  
Conservation Division  
State Corporation Commission  
211 No. Broadway  
Wichita, Kansas

WELL PLUGGING RECORD

Graham County, Sec. 27 Twp. 9 S Rge. (E) 22 (W)

Location as "NE/CNW/SW" or footage from lines 150' NE of C NE/4 SW/4

Lease Owner Clinton Oil Company

Lease Name Sandlin Well No. 1-X

Office Address 6810 West Highway U. S. 54, Wichita, Kansas

Character of Well (completed as Oil, Gas or Dry Hole) Dry

Date well completed February 16 1965

Application for plugging filed February 16 (verbal) 1965

Application for plugging approved February 16 (verbal) 1965


Plugging commenced February 16 1965

Plugging completed February 16 1965

Reason for abandonment of well or producing formation Dry

If a producing well is abandoned, date of last production 19

Was permission obtained from the Conservation Division or its agents before plugging was commenced? Yes

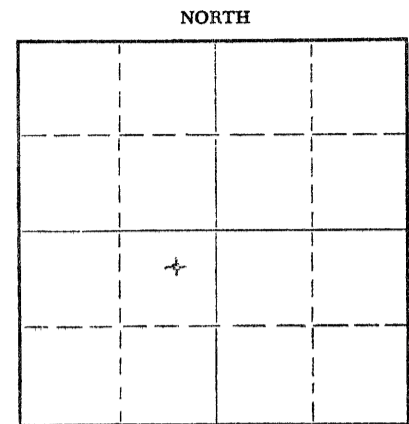

Locate well correctly on above Section Plat

Name of Conservation Agent who supervised plugging of this well W. L. Nuhole

Producing formation Depth to top Bottom Total Depth of Well 3936 Feet

Show depth and thickness of all water, oil and gas formations.

OIL, GAS OR WATER RECORDS

CASING RECORD

FORMATION	CONTENT	FROM	TO	SIZE	PUT IN	PULLED OUT

Describe in detail the manner in which the well was plugged, indicating where the mud fluid was placed and the method or methods used in introducing it into the hole. If cement or other plugs were used, state the character of same and depth placed, from feet to feet for each plug set.

Set plug at 550' - 20 sacks cement through drill pipe  
Set plug at 240' - 1/4 sack of hulls - 20 sacks cement through drill pipe  
Mud to 40' - Plug 1/2 sack hulls - 10 sacks cement to base of cellar  
Plugged rathole with 1 sack hulls - 2 sacks cement

RECEIVED  
STATE CORPORATION COMMISSION  
2/19/65  
FEB 19 1965

CONSERVATION DIVISION  
Wichita, Kansas

(If additional description is necessary, use BACK of this sheet)

Name of Plugging Contractor Garvey Drilling Company

Address Great Bend, Kansas

STATE OF Kansas, COUNTY OF Sedgwick, ss. EARL O. BRANDT (employee of owner) or (owner or operator) of the above-described well, being first duly sworn on oath, says: That I have knowledge of the facts, statements, and matters herein contained and the log of the above-described well as filed and that the same are true and correct. So help me God.

(Signature) Earl O Brandt  
6810 West Highway U. S. 54, Wichita, Kansas (Address)

SUBSCRIBED AND SWORN to before me this 17th day of February, 1965

My commission expires 7-16-67 Notary Public. Alma E. Ross

# WELL LOG

15-065-30137-00-00

COMPANY **Clinton Oil Company**

SEC. 27 T. 9S R. 22W

FARM **Sandlin**

NO. **1-X**

LOC. **App C-NE-SW**


TOTAL DEPTH **3936'**

COUNTY **Graham**

COMM. **2-8-65**

COMP. **2-16-65**

CONTRACTOR **Garvey Drilling Company**

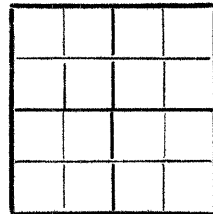

CASING **8 5/8" @ 248' w/200 sx**

ELEVATION

PRODUCTION **D & A**

FIGURES INDICATE BOTTOM OF FORMATIONS

- 100' Surface Clay and Sand
- 250' Shale
- 1290' Shale and Sand Streaks
- 1875' Shale, Sand and Red Bed
- 1884' Red Bed
- 1921' Anhydrite
- 2120' Shale and Shells
- 2505' Shale
- 2715' Shale and Lime Streaks
- 3110' Lime and Shale
- 3936' Lime
- 3936' RTD

RECEIVED  
STATE CORPORATION COMMISSION

MAR 5 1965

CONSERVATION DIVISION  
Wichita, Kansas

State of Kansas }  
County of Barton } ss

I, Sam N. Stephens of Garvey Drilling Company  
upon oath state the above and foregoing is a true and correct copy of the log of the Sandlin #1-X well.

*Sam N. Stephens*

Subscribed and sworn to before me this 1st day of March 19 65

My Commission Expires: October 19th, 1968

*Donie H. Freeman*  
NOTARY PUBLIC