


WELL PLUGGING RECORD

Information Completely
Required Affidavit
Per Deliver Report to:
Conservation Division
State Corporation Commission
211 No. Broadway
Wichita, Kansas

Graham County, Sec. 27 Twp. 9S Rge. 22W (X) (W)

NORTH

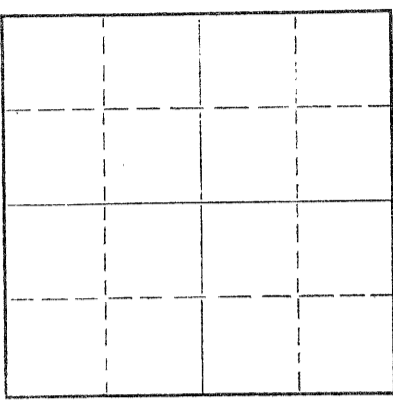

Locate well correctly on above
Section Plat

Location as "NE/CNW/SW" or footage from lines 140' NW C NW SE
Lease Owner The Shallow Water Refining Company
Lease Name Sandlin Well No. 2
Office Address 4534 Wornell Road, Kansas City, Mo.
Character of Well (completed as Oil, Gas or Dry Hole) Dry Hole
Date well completed 12-4-63 19
Application for plugging filed 12-4-63 19
Application for plugging approved 12-4-63 19
Plugging commenced 12-4-63 19
Plugging completed 12-4-63 19
Reason for abandonment of well or producing formation Dry Hole

If a producing well is abandoned, date of last production _____ 19____
Was permission obtained from the Conservation Division or its agents before plugging was commenced? yes

Name of Conservation Agent who supervised plugging of this well Bill Nichols, Morland, Kansas
Producing formation _____ Depth to top _____ Bottom _____ Total Depth of Well 3940 Feet
Show depth and thickness of all water, oil and gas formations.

OIL, GAS OR WATER RECORDS

CASING RECORD

FORMATION	CONTENT	FROM	TO	SIZE	PUT IN	PULLED OUT
				8 5/8"	207'	none

Describe in detail the manner in which the well was plugged, indicating where the mud fluid was placed and the method or methods used in introducing it into the hole. If cement or other plugs were used, state the character of same and depth placed, from _____ feet to _____ feet for each plug set.

Mud & Plug @ 550' with 20 sacks cement
Mud & Plug @ 180' with 20 sacks cement
Mud & Plug @ 40' with 10 sacks cement

RECEIVED
STATE CORPORATION COMMISSION
12/9/63
DEC 9 1963

CONSERVATION DIVISION
Wichita, Kansas

(If additional description is necessary, use BACK of this sheet)

Name of Plugging Contractor Leben Drilling, Inc.
Address P. O. Box 486, Great Bend, Kansas

STATE OF KANSAS, COUNTY OF BARTON, ss.
Leslie Kite (employee of owner) or (owner or operator) of the above-described

well, being first duly sworn on oath, says: That I have knowledge of the facts, statements, and matters herein contained and the log of the above-described well as filed and that the same are true and correct. So help me God.

(Signature) Leslie Kite
P. O. Box 486, Great Bend, Kansas
(Address)

SUBSCRIBED AND SWORN TO before me this 6th day of December, 19 63

My commission expires April 1, 1967
Ulanda Nichols Notary Public.



DRILLER'S LOG

COMPANY: The Shallow Water Refining Company
 CONTRACTOR: LEBEN DRILLING, INC.
 FARM: SANDLIN #2
 LOCATION: 140' Northwest of C NW SE
 Sec. 27-9S-22W, GRAHAM COUNTY, KANSAS
 COMMENCED: 11-27-63
 COMPLETED: 12-4-63

0	160	Sand & Shale
160	208	Shale
208	350	Shale & Sand
350	1350	Shale
1350	1860	Shale, Sand & Redbed
1860	1867	Shale
1867	1904	Anhydrite
1904	2175	Shale & Shells
2175	2520	Shale with Lime
2520	3730	Lime with Shale
3730	3940	Lime
	<u>3940</u>	<u>Rotary Total Depth - D. & A.</u>

RECEIVED
STATE CORPORATION COMMISSION

DEC 9 1963

CONSERVATION DIVISION
Wichita, Kansas

Set 8 5/8" used surface casing @ 207' with landing joint cemented with 150 sacks
Sunset with 1% Gel.

I, Leslie Kite, do hereby certify that the above and foregoing is a true and
correct copy of the log of the Sandlin #2 well, located 140' Northwest of C NW SE
of Section 27, Township 9 South, Range 22 West, Graham County, Kansas, as reflected
by the files of Leben Drilling, Inc.

Leslie Kite

Leslie Kite

STATE OF KANSAS)
) SS
COUNTY OF BARTON)

Subscribed and sworn to before me, a Notary Public, in and for Barton
County, Kansas, this 6th day of December, 1963.

Ulanda Nichols

Ulanda Nichols, Notary Public

My Commission Expires:
April 1, 1967