

15-163-20705-00-00

STATE OF KANSAS
STATE CORPORATION COMMISSION

WELL PLUGGING RECORD

Give All Information Completely
Make Required Affidavit
Mail or Deliver Report to
Conservation Division
State Corporation Comm.
245 North Water
Wichita, KS 67202

Rooks County, Sec. 23 Twp. 9 Rge. 17 ~~E~~/W
Location as "NE/CNW $\frac{1}{4}$ SW $\frac{1}{4}$ " or footage from lines

SE SE NE

Lease Owner Edmiston Oil Company

Lease Name Baxa Well No. 1

Office Address 800 Vickers KSB&T Bldg, Wichita, Kansas

Character of Well (Completed as Oil, Gas or Dry Hole)
Dry Hole

Date Well completed June 5 1977

Application for plugging filed June 5 1977

Application for plugging approved June 5 1977

Plugging commenced June 5 1977

Plugging completed June 5 1977

Reason for abandonment of well or producing formation
Dry Hole


If a producing well is abandoned, date of last production
19

Was permission obtained from the Conservation Division or
its agents before plugging was commenced? yes

Name of Conservation Agent who supervised plugging of this well Gilbert Balthazor

Producing formation Depth to top Bottom Total Depth of Well 3643

Show depth and thickness of all water, oil and gas formations.

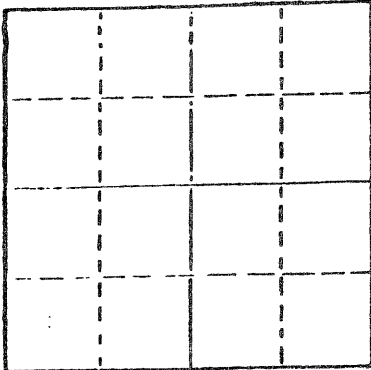

Locate well correctly on above
Section Plot

OIL, GAS OR WATER RECORDS

CASING RECORD

FORMATION	CONTENT	FROM	TO	SIZE	PUT IN	PULLED OUT

Describe in detail the manner in which the well was plugged, indicating where the mud fluid was placed and the method or methods used in introducing it into the hold. If cement or other plugs were used, state the character of same and depth placed, from _____ feet to _____ feet for each plug set.

Hole full of heavy mud to 650' w/70 sacks 50/50 Pozmix, 6% Gel., thru drill pipe
Mud to 240' w/20 sacks 50/50 Pozmix, 6% Gel thru drill pipe
Mud to 40' w/ $\frac{1}{2}$ sack hulls plug and 10 sacks cement.
2 sacks cement in rat hole.

JUN 09 1977
06-09-1977
STATE CORPORATION COMMISSION
WICHITA, KANSAS

(If additional description is necessary, use BACK of this sheet)

Name of Plugging Contractor Duke Drilling Co.

STATE OF KANSAS COUNTY OF BARTON, ss.
Larry Curtis (employee of owner) or (owner or operator)

of the above-described well, being first duly sworn on oath, says: That I have knowledge of the facts, statements, and matters herein contained and the log of the above-described well as filed and that the same are true and correct. So help me God.

(Signature) Larry Curtis
Box 823, Great Bend, Kansas
(Address)

SUBSCRIBED AND SWORN TO before me this 6th day of June, 19 77

Blanche M. Hague
Notary Public.

My commission expires April 11, 1978

15-163-20705-00-00
 DRILLERS' WELL LOG

DATE COMMENCED: May 28, 1977
 DATE COMPLETED: June 5, 1977

Himiston Oil Company
 BAKA # 1
 SE SE NE
 Sec 23-T9-R17W
 Rooks County, Kansas

ELEVATION: 2097 K.B.

0 - 40'	Clay and Post Rock
40 - 248'	Blue Shale and Sand Streaks
248 - 1090'	Shale
1090 - 1379'	Red Bed
1379 - 1419'	Anhydrite
1419 - 1590'	Red Bed
1590 - 2860'	Shale and Lime
2860 - 3218'	Lime and Shale
3218 - 3222'	Shale
3222 - 3237'	Lime and Shale
3237 - 3498'	Lime
3498 - 3536'	Lime and Shale
3536 - 3614'	Lime, Shale, Chert and Sand
3614 - 3643'	Dolomite
3643'	RTD

FORMATION TOPS

Anhydrite	1379
Heebner	3218
Kansas City	3237
Base K.C.	3498
Cong.	3536
Artuckle	3614
RTD	3643

SURFACE PIPE:
 Set used 8 5/8", 26# pipe
 at 248' w/165 sacks Common,
 2% Gel, 3% cc.

A F F I D A V I T

STATE OF KANSAS }
 COUNTY OF BARTON } ss.

Larry Curtis, of lawful age, does swear and state that the facts and statements herein contained are true and correct to the best of his knowledge.

Larry Curtis

Subscribed and sworn to before me this 7th day of June, 1977.

Meredy M. Hague
 Notary Public

My Commission Expires: April 11, 1978

RECORDED
 JUN 09 1977