


WELL PLUGGING RECORD

Give All Information Completely
Make Required Affidavit
Mail or Deliver Report to:
Conservation Division
State Corporation Commission
800 Bittling Building
Wichita, Kansas

NORTH

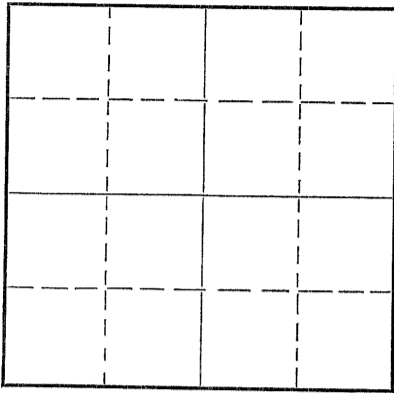

Locate well correctly on above
Section Plat

Rooks _____ County. Sec. 20 Twp. 9 Rge. 17 (E).....(W)
Location as "NE/CNW $\frac{1}{4}$ SW $\frac{1}{4}$ " or footage from lines NE NE NW
Lease Owner Dizdar Petroleum Company
Lease Name Gancung Well No. 1
Office Address 1201 Main Street, Great Bend, Kansas
Character of Well (completed as Oil, Gas or Dry Hole) Dry hole
Date well completed January 8 19 52
Application for plugging filed January 8 19 52
Application for plugging approved January 8 19 52
Plugging commenced January 8 19 52
Plugging completed January 8 19 52
Reason for abandonment of well or producing formation Dry hole

If a producing well is abandoned, date of last production _____ 19_____
Was permission obtained from the Conservation Division or its agents before plugging was commenced? yes

Name of Conservation Agent who supervised plugging of this well Eldon Petty
Producing formation _____ Depth to top _____ Bottom _____ Total Depth of Well 3620 Feet
Show depth and thickness of all water, oil and gas formations.

OIL, GAS OR WATER RECORDS

CASING RECORD

Formation	Content	From	To	Size	Put In	Pulled Out
				8 5/8"	106'	none

Describe in detail the manner in which the well was plugged, indicating where the mud fluid was placed and the method or methods used in introducing it into the hole. If cement or other plugs were used, state the character of same and depth placed, from _____ feet to _____ feet for each plug set.

Cementers plug set at 150' with 1/2 sack hulls and 15 sacks cement,
2nd plug set at 40' with 1/2 sack hulls and 10 sacks cement. Hole
cemented to bottom of cellar.

JAN 29 1952
01-29-1952

(If additional description is necessary, use BACK of this sheet)
Correspondence regarding this well should be addressed to Dizdar Petroleum Company
Address 1201 Main St., Great Bend, Kansas

STATE OF Kansas, COUNTY OF Ellis, ss.

Claude N. Bard (employee of owner) or (owner or operator) of the above-described well,
being first duly sworn on oath, says: That I have knowledge of the facts, statements, and matters herein contained and the log of the above-described well as filed and that the same are true and correct. So help me God.

(Signature) Claude N. Bard
Plainville, Kansas (Address)

SUBSCRIBED AND SWORN to before me this 28th day of January, 1952

My commission expires May 9, 1953
John L. Spier Notary Public.

PLUGGING
28-3273-s 4-50-10M
JAN 29 1952
136 40

15-163-30324-00-00

Company: Dizdar Petroleum Company
Contractor: Dizdar & Nye Drilling Company
Commenced: December 22, 1951
Completed: January 8, 1952

Farm: Ganoung No. 1 Well
Location: NE NE NW 20-9-17W
Rooks County, Kansas
Casing Record: 8 5/8" set at 106'
Dry and Abandoned

(Figures below indicate bottoms)

surface soil	30
rock and shale	85
blue shale	106
sandy and sticky shale	680
sandy shale	900
sand & shale	1210
shale & shells	1470
shale & shells	1790
shale & shells	2030
shale & lime	2110
shale lime	2290
lime shale	2355
shale & shells	2525
shale & lime	2650
shale lime	2745
shale	2860
shale	2880
shale & lime	2955
shale lime	3055
shale & lime	3110
shale & lime	3150
lime & shale	3190
lime	3225
lime & shale	3245
lime & shale	3285
lime & shale	3325
lime & shale	3350
shale & lime	3390
lime & shale	3405
lime shale	3435
shale lime	3470
lime & shale	3500
lime & shale	3505
lime & shale	3550
lime	3580
Conglomerate	3600
lime shale	3620 T. D.

I hereby certify that this is a true and correct log of the above described well as shown by the drilling reports.

DIZDAR & NYE DRILLING COMPANY

By & James R. Nye

STATE OF KANSAS)
) SS
ELLIS COUNTY)

Subscribed and sworn to before me, a Notary Public, in and for said County and State this 28 day of January, 1952

John L. Spiess
Notary Public

My Commission Expires, May 9, 1953

PLUGGING
FILE NO. 20-9-17W
WELL PAGE 136 LINE 40

JAN 29 1952