

STATE OF KANSAS
STATE CORPORATION COMMISSION

15-163-00704-00-00


WELL PLUGGING RECORD

Give All Information Completely
Make Required Affidavit
Mail or Deliver Report to:
Conservation Division
State Corporation Commission
800 Biting Building
Wichita, Kansas

Rooks County. Sec. 23 Twp. 9S Rge. (E) 17 (W)

Location as "NE/CNW%SW%" or footage from lines NW NW SE
Lease Owner Powell Drilling Company
Lease Name Baxa Well No. 1
Office Address 909 Central Bldg., Wichita, Kans.
Character of Well (completed as Oil, Gas or Dry Hole) Dry Hole
Date well completed December 3 1954
Application for plugging filed December 3 1954
Application for plugging approved December 3 1954
Plugging commenced December 3 1954
Plugging completed December 3 1954
Reason for abandonment of well or producing formation Dry

NORTH

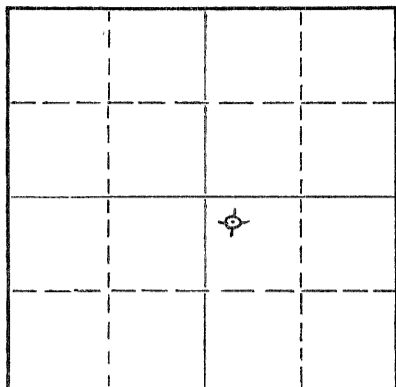

Locate well correctly on above
Section Plat

If a producing well is abandoned, date of last production _____ 19____
Was permission obtained from the Conservation Division or its agents before plugging was commenced? Yes

Name of Conservation Agent who supervised plugging of this well Eldon Petty
Producing formation _____ Depth to top _____ Bottom _____ Total Depth of Well 3626 Feet
Show depth and thickness of all water, oil and gas formations.

OIL, GAS OR WATER RECORDS

CASING RECORD

FORMATION	CONTENT	FROM	TO	SIZE	PUT IN	PULLED OUT
				8-5/8"	206'	-0-

Describe in detail the manner in which the well was plugged, indicating where the mud fluid was placed and the method or methods used in introducing it into the hole. If cement or other plugs were used, state the character of same and depth placed, from _____ feet to _____ feet for each plug set.

Set Plug at 195' - Filled up with 15 sacks of cement and 1/2 sack hulls;
Set second plug at 40' and filled up with 10 sacks of cement and 1/2 sack
of hulls.

(If additional description is necessary, use BACK of this sheet)

Name of Plugging Contractor Powell Drilling Company
Address 909 Central Bldg., Wichita, Kansas

STATE OF Kansas, COUNTY OF Sedgwick, ss.
C. M. Powell, Jr. ~~X Employee of Owner~~ (owner or operator) of the above-described well, being first duly sworn on oath, says: That I have knowledge of the facts, statements, and matters herein contained and the log of the above-described well as filed and that the same are true and correct. So help me God.

(Signature) [Signature]
909 Central Bldg., Wichita, Kansas
(Address)

SUBSCRIBED AND SWORN TO before me this 9th day of December, 1954

My commission expires February 5, 1958
Billie Ann Green Notary Public.

PLUGGING
FILE SEC. 23 T. 9 R. 17W
BOOK PAGE 82 LINE 24

RECEIVED
STATE OF KANSAS
DEC 10 1954
CONSERVATION DIVISION

15-163-00704-00-00

POWELL DRILLING COMPANY
Wichita, Kansas

DRILLERS WELL LOG

Baxa #1

NW NW SE Section 23-9S-17W

Rooks County, Kansas

Commenced R.D. 11/23/54

Elevation: 2108 D.F.

Completed R.D. 12/3/54

Initial Production: Dry

Total Depth: 3626'

Contractor: Powell Drilling Co.

Casing Record: 206' 8-5/8" 28# surface casing

<u>STRATA</u>	<u>DEPTH</u>
Shale & Shells	0 - 206'
Shale	206 - 580
Sand	580 - 690
Sand & Shale	690 - 995
Dakota Sand	995 - 1100
Sand & Shale	1100 - 1350
Shale & Shells	1350 - 1397
Anhydrite	1397 - 1432
Shale & Shells	1432 - 1800
Salt & Shale	1800 - 1960
Lime	1960 - 1985
Lime & Shale	1985 - 2365
Shale	2365 - 2500
Lime & Shale	2500 - 2800
Shale	2800 - 2940
Shale & Shells	2940 - 3014
Lime	3014 - 3500
Shale & Lime	3500 - 3546
Cherty Conglomerate	3546 - 3605
Chert & Shale	3605 - 3613
Lime	3613 - 3626

TOPS:

Cimarron anhydrite	1397'
Topeka Lime	3013
Heebner Shale	3231
Toronto Lime	3252
Lansing-Kansas City Lime	3272
Sooy Conglomerate	3546
Arbuckle Dolomite	3613

