

15-163-30332-00-00

Give All Information Completely
Make Required Affidavit
Mail or Deliver Report to:
Conservation Division
State Corporation Commission
211 No. Broadway
Wichita, Kansas

WELL PLUGGING RECORD

Rocks _____ County, Sec. 28 Twp. 9S Rge. 17W (E)____(W)

Location as "NE/CNW/SW" or footage from lines C/S/2, SW/NE

Lease Owner Republic Drilling Co.

Lease Name Watkins Well No. 1

Office Address c/o Harold Krueger, Natoma, Kansas

Character of Well (completed as Oil, Gas or Dry Hole) Dry Hole

Date well completed May 25, 19 65

Application for plugging filed May 25, 19 65

Application for plugging approved May 25 19 65


Plugging commenced May 25 19 65

Plugging completed May 25 19 65

Reason for abandonment of well or producing formation No production

If a producing well is abandoned, date of last production _____ 19 _____

Was permission obtained from the Conservation Division or its agents before plugging was commenced? Yes

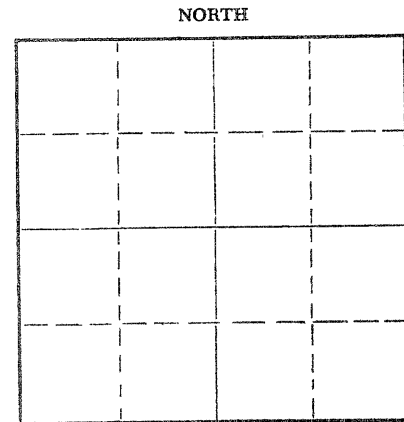

Locate well correctly on above Section Plat

Name of Conservation Agent who supervised plugging of this well Eldon Petty, Box 326, Hays, Kansas

Producing formation _____ Depth to top _____ Bottom _____ Total Depth of Well _____ Feet

Show depth and thickness of all water, oil and gas formations.

OIL, GAS OR WATER RECORDS

CASING RECORD

FORMATION	CONTENT	FROM	TO	SIZE	PUT IN	PULLED OUT
				8 5/8"	184.30	None

Describe in detail the manner in which the well was plugged, indicating where the mud fluid was placed and the method or methods used in introducing it into the hole. If cement or other plugs were used, state the character of same and depth placed, from _____ feet to _____ feet for each plug set.

Filled hole with heavy mud to 540', set plug, cemented with 20 sacks
Filled hole with heavy mud to 180', set plug, cemented with 20 sacks
Filled hole with heavy mud to 35', set plug, cemented with 10 sacks to bottom of cellar

RECEIVED
STATE CORPORATION COMMISSION
JUL 1 1965
07-01-1965
CONSERVATION DIV.
WICHITA, KANSAS

(If additional description is necessary, use BACK of this sheet)
Name of Plugging Contractor Transit Corporation
Address 1516 Liberty Bank Bldg., Oklahoma City, Oklahoma 73102

STATE OF Oklahoma, COUNTY OF Oklahoma, ss.
L. J. Kruse (employee of owner) ~~owner~~ of the above-described well, being first duly sworn on oath, says: That I have knowledge of the facts, statements, and matters herein contained and the log of the above-described well as filed and that the same are true and correct. So help me God.

(Signature) L. J. Kruse

SUBSCRIBED AND SWORN TO before me this 28th day of June, 19 65

My commission expires January 3, 1966 Paul E. Gashen Notary Public.



15-163-30332-00-00

DRILLERS' WELL LOG

Republic Drilling Co.

Watkins # 1, located in
C/S/2, SW/NW, Section 28-9S-17W
Rooks County, Kansas

Commenced: May 16, 1965
Completed: May 25, 1965
Elevation: 2117 K.B.

Casing: 8 5/8" @ 186'
Cemented: w/140 sacks

<u>Formation</u>	<u>From</u>	<u>To</u>
Surface soil	0	40
Sand	40	50
Shells	50	120
Sand	120	130
Shale	130	186
Shale and shells	186	965
Sand	965	1150
Shale	1150	1416
Anhydrite	1416	1456
Shale, shells and Red Bed	1456	1880
Shale and shells	1880	1960
Shale and lime	1960	2055
Lime w/shale	2055	2230
Lime and shale	2230	2325
Shale w/lime streaks	2325	2390
Lime and shale	2390	3035
Lime	3035	3175
Lime and shale	3175	3245
Lime	3245	3610
Lime and chert	3610	3620
Arbuckle	3620	3670 T.D.

I hereby certify the foregoing to be a true and correct drillers' log of the formations encountered in the above well.

Subscribed and sworn to before me

this 28th day of June, 1965

TRANSIT CORPORATION

By L. J. Kuse

My commission expires January 3, 1966

Paul E. Gathers
Notary Public

RECEIVED
STATE CORPORATION COMMISSIONER

JUL 1 1965

CONSERVATION DIVISION
Wichita, Kansas