


WELL PLUGGING RECORD

Give All Information Completely
Make Required Affidavit
Mail or Deliver Report to:
Conservation Division
State Corporation Commission
800 Bittling Building
Wichita, Kansas

NORTH

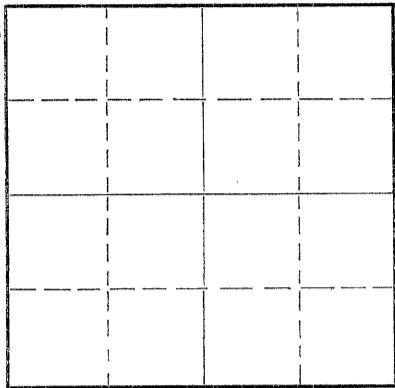

Locate well correctly on above
Section Plat

.....Rocks.....County. Sec. 27 Twp. 9 Rge. (E) 17 (W)
Location as "NE/CNW¹/₄SW¹/₄" or footage from lines 330'W 330'S of E/4 Corner
Lease Owner Cities Service Oil Co.
Lease Name Benedick Well No. 1
Office Address Bartlesville, Oklahoma
Character of Well (completed as Oil, Gas or Dry Hole) dry hole
Date well completed 7/31 1950
Application for plugging filed 7/31 1950
Application for plugging approved 7/31 1950
Plugging commenced 7/31 1950
Plugging completed 8/1 1950
Reason for abandonment of well or producing formation Dry Hole

If a producing well is abandoned, date of last production..... 19.....
Was permission obtained from the Conservation Division or its agents before plugging was commenced?.....yes.....

Name of Conservation Agent who supervised plugging of this well Mr. Eldon Petty
Producing formation Arbuckle Lime Depth to top 3637 Bottom..... Total Depth of Well 3650 Feet
Show depth and thickness of all water, oil and gas formations.

OIL, GAS OR WATER RECORDS

CASING RECORD

Formation	Content	From	To	Size	Put In	Pulled Out
<u>Arbuckle Lime</u>	<u>dry</u>			<u>8-5/8</u>	<u>240'</u>	<u>None</u>

Describe in detail the manner in which the well was plugged, indicating where the mud fluid was placed and the method or methods used in introducing it into the hole. If cement or other plugs were used, state the character of same and depth placed, from.....feet to.....feet for each plug set.

Filled with heavy mud from 3650' to 235' set plug and put in 15
sacks cement thru drill pipe, heavy mud from 190' to 35', set
plug at 35' and 10 sacks cement thru drill pipe to 3' mud and
dirt to surface

09-12-1950

(If additional description is necessary, use BACK of this sheet)

Correspondence regarding this well should be addressed to.....Mr. R. C. Cooper, Box 751
Address.....Great Bend, Kansas

STATE OF Kansas, COUNTY OF Barton, ss.

James Porter.....(employee of owner) or (~~OWNER OR OPERATOR~~) of the above-described well,
being first duly sworn on oath, says: That I have knowledge of the facts, statements, and matters herein contained and the log of the above-described well as filed and that the same are true and correct. So help me God.


(Signature)

Box 553, Russell, Kansas
(Address)

SUBSCRIBED AND SWORN to before me this 16th day of August, 19 50.

My commission expires March 31, 1954

Notary Public.

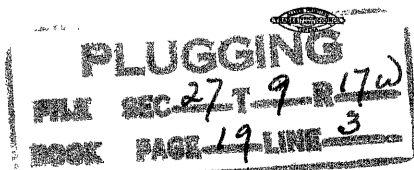

15-163-00393-00-00
WELL RECORD

Company Cities Service Oil Co. Well No. 1 Farm Dandick
 Location 330' West and 330' South of E/4 Corner Sec. 27 T. 9 R. 17W
 Elevation 2096 (2096 Gr.) County Hooks State Kansas
 Drlg. Comm. July 18, 1950 Contractor Helm Drilling Company
 Drlg. Comp. July 31, 1950 Acid None
 T. D. 3650' Initial Prod. None - Dry Hole; P. & A. 7-31-50

CASING RECORD:

8-5/8" @ 240' cas. 175 ex cement

FORMATION RECORD:

shale & shells	0-950
sand, shale & shells	1025
shale & shells	1095
red bed & shells	1360
anhydrite	1400
shale & shells	1685
shlt, shale & shells	1775
shale & shells	2145
shale & lime	2460
lime & shale	2735
shale & lime	2865
lime & shale	3030
lime	3535
conglomerate	3635
lime	3650 T. D.

Topoka	3011'
Hoehner	3225'
Dodge	3245'
Lansing	3268'
Sandy Conglomerate	3516'
Cherty Conglomerate	3597'
Arbuckle	3636'
Penetration	14'
Total Depth	3650'

Drill stem test 3338-50 recovered
5' slightly oil-cut mud in 30 mins.

Drill stem test 3377-56 recovered
2' mud in 30 mins.

Drill stem test 3427-45 recovered
4' mud in 30 mins.

SFO: 500' 2°
 1000' 2°
 1500' 2°
 2000' 2°
 2500' 1°
 3000' 1°

7-7/8" rotary hole.

PLUGGING
 FILE SEC. 27 T. 9 R. 17W
 PAGE 19 LINE 3