


STATE OF KANSAS
STATE CORPORATION COMMISSION

Give All Information Completely
Make Required Affidavit
Mail or Deliver Report to:
Conservation Division
State Corporation Commission
211 No. Broadway
Wichita, Kansas

15-163-00770-00-00

WELL PLUGGING RECORD

NORTH

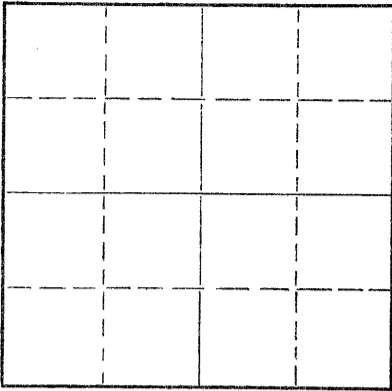

Locate well correctly on above
Section Plat

Rocks

County. Sec. 35 Twp. 9S Rge. 17 (X) W (XV)

Location as "NE/CNW/SW" or footage from lines C SW SE

Lease Owner Davis Bros. Transit Corporation

Lease Name Westhusin "A"

Well No. 1

Office Address 1516 Liberty Bank Building, Oklahoma City, Oklahoma

Character of Well (completed as Oil, Gas or Dry Hole) D & A

Date well completed September 12, 19 58

Application for plugging filed September 12, 19 58

Application for plugging approved September 12, 19 58

Plugging commenced September 12, 19 58

Plugging completed September 12, 19 58

Reason for abandonment of well or producing formation No Production

If a producing well is abandoned, date of last production _____ 19 _____

Was permission obtained from the Conservation Division or its agents before plugging was commenced? Yes

Name of Conservation Agent who supervised plugging of this well Eldon Petty, Box 326, Hays, Kansas

Producing formation _____ Depth to top _____ Bottom _____ Total Depth of Well _____ Feet

Show depth and thickness of all water, oil and gas formations.

OIL, GAS OR WATER RECORDS

CASING RECORD

FORMATION	CONTENT	FROM	TO	SIZE	PUT IN	PULLED OUT
				8 5/8"	173'	None

Describe in detail the manner in which the well was plugged, indicating where the mud fluid was placed and the method or methods used in introducing it into the hole. If cement or other plugs were used, state the character of same and depth placed, from _____ feet to _____ feet for each plug set.

Filled hole with heavy drilling mud to 550'; set plug, cemented with 20 sacks of cement

Filled hole with heavy drilling mud to 160'; set plug, cemented with 15 sacks of cement

Filled hole with heavy drilling mud to 40'; set plug, cemented with 9 sacks of cement to bottom of cellar

(If additional description is necessary, use BACK of this sheet)

Name of Plugging Contractor Transit Corporation

Address 1516 Liberty Bank Building, Oklahoma City, Oklahoma

STATE OF Oklahoma, COUNTY OF Oklahoma, ss.

Paul E. Gathers

(employee of owner) or (owner or operator) of the above-described well, being first duly sworn on oath, says: That I have knowledge of the facts, statements, and matters herein contained and the log of the above-described well as filed and that the same are true and correct. So help me God.

(Signature) Paul E. Gathers

(Address)

SUBSCRIBED AND SWORN TO before me this 30th. day of September, 19 58

Mildred Jean

My commission expires May 17, 1962

Notary Public.

PLUGGING
FILE SEC 35 T. 9 R. 17W
BOOK PAGE 131 LINE 32

10-02-1958

15-163-00770 -00-00

DRILLER'S WELL LOG

Davis Bros.--Transit Corporation - Westhusin "A" # 1 located in
C SW SE Sec. 35-9S-17W,
Rocks County, Kansas

Commenced: August 31, 1958
Completed: September 12, 1958
Elevation: 2084 KB

Casing 8 5/8" @ 173'
Cemented w/125 sacks

<u>Formation</u>	<u>From</u>	<u>To</u>
Surface Clay	0	40
Gravel	40	125
Clay and shells	125	165
Blue shale	165	173
Shale	173	225
Shale and shells	225	855
Sand	855	975
Pyrite streaks and shale	975	1145
Shale and pyrite	1145	1295
Anhydrite	1295	1357
Shale	1357	1640
Shale and lime streaks	1640	1895
Lime and shale	1895	2479
Shale and lime	2479	2575
Lime and shale	2575	2680
Shale and lime	2680	2860
Shale and lime streaks	2860	2995
Lime	2995	3103
Lime and shale streaks	3103	3150
Lime	3150	3265
Lime and shale	3265	3316
Lime	3316	3623 TD

Summary of Formation

Topeka	2976'
Heebner	3199'
Toronto	3217'
Lansing-K.C.	3240'
Base of K.C.	3483'
Conglomerate	3521'
Simpson Dolo.	3568'
Arbuckle Dolo.	3593'

I hereby certify the foregoing to be a true and accurate Driller's Log of the formation encountered in the above well.

Subscribed and sworn to before me
this 30th. day of September, 1958.

My Commission expires May 17, 1962.

TRANSIT CORPORATION

By Paul E. Gathers

Mildred Jean
Notary Public

PLUGGING			
FILE	SEC 35	T 9	R 17W
BOOK	PAGE 131	LIN E 32	