


15-163-02531-00-00

STATE OF KANSAS  
STATE CORPORATION COMMISSION

Give All Information Completely  
Make Required Affidavit  
Mail or Deliver Report to:  
Conservation Division  
State Corporation Commission  
800 Bitting Building  
Wichita, Kansas

WELL PLUGGING RECORD

NORTH

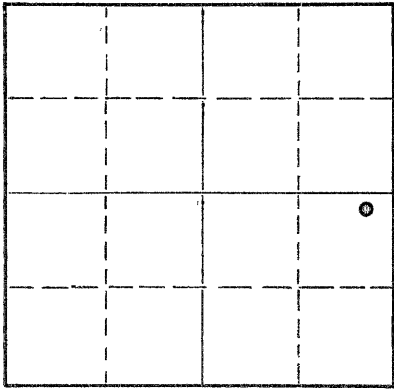

Locate well correctly on above  
Section Plat

Rooks County. Sec. 36 Twp. 9 Rge. (E) 18 (W)  
Location as "NE/CNW/SW" or footage from lines NE NE SE  
Lease Owner Murfin Drilling Company  
Lease Name Posegate Well No. 1  
Office Address 507 Union Nat'l Bank Bldg., Wichita, Kansas  
Character of Well (completed as Oil, Gas or Dry Hole) Dry Hole  
Date well completed 6-27 19 54  
Application for plugging filed 6-27 19 54  
Application for plugging approved 6-28 19 54  
Plugging commenced 6-27 19 54  
Plugging completed 6-27 19 54  
Reason for abandonment of well or producing formation Dry

If a producing well is abandoned, date of last production \_\_\_\_\_ 19\_\_\_\_  
Was permission obtained from the Conservation Division or its agents before plugging was commenced? yes

Name of Conservation Agent who supervised plugging of this well Eldon Petty, Hays, Kansas  
Producing formation \_\_\_\_\_ Depth to top \_\_\_\_\_ Bottom \_\_\_\_\_ Total Depth of Well 3681 Feet  
Show depth and thickness of all water, oil and gas formations.

OIL, GAS OR WATER RECORDS

CASING RECORD

FORMATION	CONTENT	FROM	TO	SIZE	PUT IN	PULLED OUT
				8 5/8	192'	-

Describe in detail the manner in which the well was plugged, indicating where the mud fluid was placed and the method or methods used in introducing it into the hole. If cement or other plugs were used, state the character of same and depth placed, from \_\_\_\_\_ feet to \_\_\_\_\_ feet for each plug set.

Filled hole to 180'. Set 1st plug with hulls.  
Mix & displace 15 sacks cement.  
2nd plug with 1/2 sack hulls.  
Mix & displace 10 sacks cement.

RECEIVED  
STATE CORPORATION COMMISSION  
JUL 3 1954  
CONSERVATION DIVISION  
Wichita, Kansas

7-3-54

(If additional description is necessary, use BACK of this sheet)

Name of Plugging Contractor Murfin Drilling Company  
Address 507 Union Nat'l Bank Bldg - Wichita, Kansas

STATE OF Kansas, COUNTY OF Sedgwick, ss.  
W. R. Murfin (employee of owner) or (owner or operator) of the above-described well, being first duly sworn on oath, says: That I have knowledge of the facts, statements, and matters herein contained and the log of the above-described well as filed and that the same are true and correct. So help me God.

(Signature) W.R. Murfin  
507 Union Nat'l Bank Bldg - Wichita  
(Address)

SUBSCRIBED AND SWORN TO before me this 2nd day of July, 19 54.

My commission expires 6-4-55. Abby Heimerman Notary Public.

PLUGGING  
36 9 18W  
PAGE 44 LINE 41

WELL LOG

15-103-02531-00-00

COMPANY Murfin et al

SEC. 36 T. 9 R. 18W  
LOC. NE NE SE

FARM Posegate

NO. 1

TOTAL DEPTH 3681'

COMM. 6-17-54


COMP. 6-27-54

SHOT OR TREATED

CONTRACTOR Murfin Drilling Co.

ISSUED

COUNTY Rooks  
KANSAS

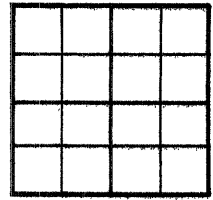

ELEVATION 2132 RB - 2129 DF

PRODUCTION D & A

CASING

20	10
15	8 5/8" w/140 sax Bulk Cement
12	6
13	5

FIGURES INDICATE BOTTOM OF FORMATIONS

192	Shale, sand, lime	Tops:		
800	Shale, shells	3059	+927	Topeka Lime
880	Sand	3272	+1140	Heebner
1225	Shale, shells, sand	3290	-1158	Toronto
1437	Shale, red bed	3314	-1182	LKC
1470	Anhydrite	3556	-1424	Cherty Cgl.
1925	Shale, shells	3594	-1462	Simpson Dolomite
2115	Shale, lime	3628	-1496	Arbuckle
2230	Lime, shale	3681		RTD
2360	Lime			
2480	Lime, shale			
3110	Shale, lime			
3195	Lime, shale			
3255	Lime			
3310	Shale, lime			
3628	Lime			
3675	Arbuckle			
3681	Lime			
3681	T. D.			

7-3-54

State of Kansas }  
County of Sedgwick } ss:

I, W. R. Murfin of the Murfin Drilling Company

upon oath state that the above and foregoing is a true and correct copy of the log of the Posegate #1 well.

W.R. Murfin

Subscribed and sworn to before me this 2nd day of July 1954

My Commission Expires: 6-4-55

Abby Heimerman  
NOTARY PUBLIC

PLUGGING  
FILE SEC 36 T 9 R 18W  
BOOK PAGE 44 LINE 41