


15-163-20759-00-00

STATE OF KANSAS
STATE CORPORATION COMMISSION

WELL PLUGGING RECORD

Give All Information Completely
Make Required Affidavit
Mail or Deliver Report to
Conservation Division
State Corporation Comm.
245 North Water
Wichita, KS 67202

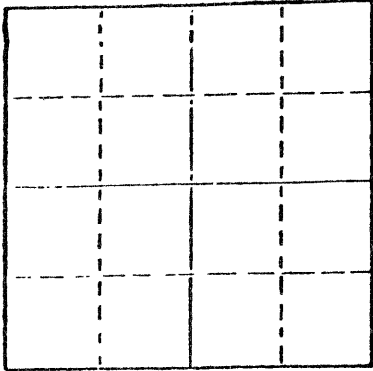

Locate well correctly on above
Section Plat

Rooks County, Sec. 36 Twp. 9 Rge. 18 NW
Location as "NE/CNW $\frac{1}{4}$ SW $\frac{1}{4}$ " or footage from lines
NW NE NW
Lease Owner Liberty Enterprises, Inc.
Lease Name Winters Well No. #1
Office Address 308 West Mill Plainville, Ks. 67663
Character of Well (Completed as Oil, Gas or Dry Hole)
Dry Hole
Date Well completed January 6, 19 78
Application for plugging filed January 6, 19 78
Application for plugging approved January 6, 10:00a.m. 19 78
Plugging commenced January 6, 11:00a.m. 19 78
Plugging completed January 6, 1:00 p.m. 19 78
Reason for abandonment of well or producing formation
of no commercial value
If a producing well is abandoned, date of last production
19
Was permission obtained from the Conservation Division or
its agents before plugging was commenced? Yes
Name of Conservation Agent who supervised plugging of this well Leo Massey
Producing formation None Depth to top Bottom Total Depth of Well 3583'
Show depth and thickness of all water, oil and gas formations.

OIL, GAS OR WATER RECORDS

CASING RECORD

| FORMATION | CONTENT | FROM | TO | SIZE | PUT IN | PULLED OUT |
|-------------------|---------|------|--------|-------|--------|------------|
| Surface Past Rock | | 0 | 210.34 | 8 5/8 | 210.34 | None |
| | | | | | | |
| | | | | | | |

Describe in detail the manner in which the well was plugged, indicating where the mud fluid was placed and the method or methods used in introducing it into the hold. If cement or other plugs were used, state the character of same and depth placed, from _____ feet to _____ feet for each plug set. Plugged hole with 50-50 Pozmix 60% gel
Spot 70sxs @ 660'
20 sxs @ 185' plug & 1/2 sack hulls
Plug @ 40' 40' to surface 10sxs
2sxs in rat hole
Plug at 10'

JAN 13 1978
CONSERVATION DIVISION
WICHITA, KANSAS

Leo Massey & Allied Cementing Co.

1-13-78

(If additional description is necessary, use BACK of this sheet)

Name of Plugging Contractor Pioneer Drilling Co., Inc. 308 W. Mill Plainville, Ks. 67663


STATE OF Kansas COUNTY OF Rooks, ss.
Charles G. Comeau (Geologist) (employee of owner) or (owner or operator)
of the above-described well, being first duly sworn on oath, says: That I have knowledge of the facts, statements, and matters herein contained and the log of the above-described well as filed and that the same are true and correct. So help me God.

(Signature) Charles G. Comeau
308 West Mill Plainville, Ks.
(Address)

SUBSCRIBED AND SWORN TO before me this 11th day of January, 1978

Krystal Schwenn
Notary Public.

My commission expires

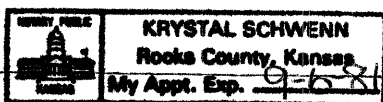

15-163-20759-00-00

DRILLERS LOG

WINTERS #1

CASING RECORD:

8 5/8 " set at 210.34'
130 sxs 2% gel

TOTAL DEPTH:

3583'

DESCRIPTION:

NW NE NW
Sec. 36-9s-18w, Rooks County, Ks.

OPERATOR: Liberty Enterprises, Inc.

CONTRACTOR: Pioneer Drilling Co., Inc.

COMMENCED: December 21, 1977

COMPLETED: January 6, 1978

| FORMATION | FROM | TO | REMARKS |
|--------------|------|------|---------|
| Lime & Shale | 0 | 230 | |
| Shale | 230 | 823 | |
| Shale & Sand | 823 | 1349 | |
| Lime | 1349 | 1380 | |
| Lime | 1380 | 1386 | |
| Shale | 1386 | 1635 | |
| Shale | 1635 | 1819 | |
| Shale | 1819 | 1995 | |
| Lime & Shale | 1995 | 2115 | |
| Lime & Shale | 2115 | 2226 | |
| Lime & Shale | 2226 | 2390 | |
| Lime & Shale | 2390 | 2490 | |
| Shale & Lime | 2490 | 2436 | |
| Shale & Lime | 2536 | 2658 | |
| Shale & Lime | 2658 | 2785 | |
| Shale & Lime | 2785 | 2910 | |
| Lime | 2910 | 3014 | |
| Lime & Shale | 3014 | 3130 | |
| Lime & Shale | 3130 | 3215 | |
| Lime | 3215 | 2382 | |
| Lime & Shale | 3282 | 3335 | |
| Lime | 3335 | 3345 | |
| Lime & Shale | 3345 | 3385 | |
| Lime | 3385 | 3430 | |
| Lime | 3430 | 3475 | |
| Lime | 3475 | 3425 | |
| Lime | 3425 | 3570 | |
| Lime | 3570 | 3583 | |
| T.D. | | 3583 | |


RECEIVED
STATE CORPORATION COMMISSION
JAN 20 1978
CONSERVATION DIVISION
Wichita, Kansas
1-20-78

I certify that this is a true and correct copy of the above log to the best of my knowledge.

PIONEER DRILLING CO., INC.

Roger L. Comeau
Roger L. Comeau

Subscribed and sworn to before me this 13th day of January, 1978.

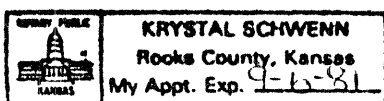

Krystal Schwenn
Notary Public

500