


15-163-00969-00-00

WELL PLUGGING RECORD

Give All Information Completely
Make Required Affidavit
Mail or Deliver Report to:
Conservation Division
State Corporation Commission
800 Bittling Building
Wichita, Kansas

NORTH

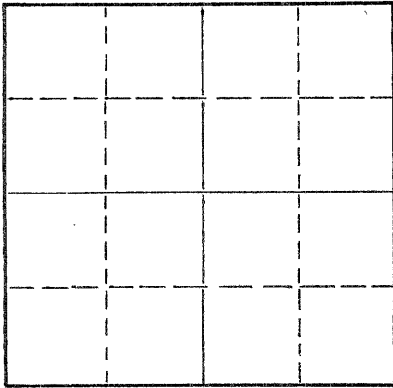

Locate well correctly on above
Section Plat

~~XXXXXX~~ Rooks County. Sec. 7 Twp. 9 Rge. 17 (E) W (W)
Location as "NE/CNW/SW" or footage from lines NW/4 NW/4 NE/4

Lease Owner V.D. Sidey Oil Company
Lease Name Sidey Oil Co. - Fischer Well No. 1
Office Address Russell, Kansas.

Character of Well (completed as Oil, Gas or Dry Hole) _____
Date well completed _____ 19____
Application for plugging filed _____ 19____
Application for plugging approved _____ 19____
Plugging commenced Feb. 20, 1956 _____ 19____
Plugging completed Feb. 29, 1956 _____ 19____
Reason for abandonment of well or producing formation _____

If a producing well is abandoned, date of last production _____ 19____
Was permission obtained from the Conservation Division or its agents before plugging was commenced? yes.

Name of Conservation Agent who supervised plugging of this well Eldon Petty
Producing formation _____ Depth to top _____ Bottom _____ Total Depth of Well 3395 Feet
Show depth and thickness of all water, oil and gas formations.

OIL, GAS OR WATER RECORDS

CASING RECORD

FORMATION	CONTENT	FROM	TO	SIZE	PUT IN	PULLED OUT

Describe in detail the manner in which the well was plugged, indicating where the mud fluid was placed and the method or methods used in introducing it into the hole. If cement or other plugs were used, state the character of same and depth placed, from 3395 feet to surface feet for each plug set.

Hole filled with sand from 3395 to 3290 ft; Four sacks of cement placed in hole with dump bailer to form cement plug from 3290 to 3258; Hole filled with mud by halliburton Pump trucks, with churned in 30 sacks of mud, followed by plug, and pumped down with fifty sacks of cement. Plugging Complete.

03-13-1956

(If additional description is necessary, use BACK of this sheet)

Name of Plugging Contractor Barnes and Sons Pipe Pulling Co.,
Address Russell, Kansas.

STATE OF KANSAS, COUNTY OF RUSSELL, ss.


V. D. Sidey (~~employee of owner~~) (~~owner~~ ~~operator~~) of the above-described well, being first duly sworn on oath, says: That I have knowledge of the facts, statements, and matters herein contained and the log of the above-described well as filed and that the same are true and correct. So help me God.

(Signature) V. D. Sidey
Box 387 Russell, Kansas
(Address)

SUBSCRIBED AND SWORN TO before me this 12th day of March 1956

My commission expires September 17, 1956

Marguerite Reynes
Notary Public.

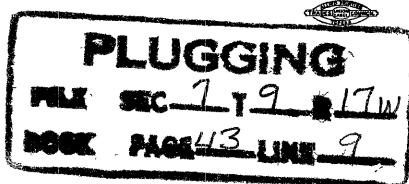

15-163-00969-00-00

SIDEY DRILLING CO.

BUILDING & LOAN BLDG. P. O. BOX 387
RUSSELL, KANSAS

Company V. D. Sidey Oil Company

Sec. 9 7 T. 9 R. 17

Farm FISCHER

No. 1

Loc. 6 NW NW NE

Total Depth 3395

Comm. 11/29/55

Comp. 12/9/55

Shot or Treated

County Rocks

Contractor Sidey Drilling Company

Issued

Casing

20
15 1/2
12 1/2
13%

10
8 1/4 102'
6%
5 5/16 3393'

Elevation 1959 DF
1957 Gr
Production

Figures Indicate Bottom of Formations

0-40	Shale	2145-2205	Shale & Lime
40-45	Sand	2205-2350	Lime & Shale
45-102	Blue Shale	2350-2445	Lime & Shale
102-150	Shale	2445-2490	Lime & Shale
150-500	Shale & Shells	2490-2560	Lime
500-550	Shale & shell	2560-2585	Lime & Shale
550-685	Shale & shells	2585-2705	Lime & Shale
685-725	Shale	2705-2775	Lime & Shale
725-755	Sand & Shale	2775-2860	Shale
755-795	Sand	2860-2915	Lime & Shale
795-820	Shale & Shells	2915-3000	Lime & Shale
820-965	Shale	3000-3080	Lime & Shale
965-1010	Sand	3080-3140	Lime
1010-1288	Red Bed	3140-3205	Lime
1288-1320	Anhydrite	3205-3260	Lime
1320-1332	Anhydrite	3260-3305	Lime
1332-1620	Shale & Shells	3305-3353	Lime
1620-1820	Shale & shells	3353-3386	Lime
1820-2030	Shale & Limeshells	3386-3395	Lime
2030-2145	Lime & Shale		TD

STATE OF KANSAS, COUNTY OF RUSSELL, ss.

I, V. D. Sidey, of the SIDEY DRILLING COMPANY, upon oath state that the above and foregoing is a true and correct copy of the log of the FISCHER #1 well.

V. D. Sidey
V. D. SIDEY

Subscribed and sworn to before me this 31st day of December, 1955.

Marguerite Bigner
NOTARY PUBLIC

My Commission Expires: Sept. 17, 1956

PLUGGING
FILE SEC 7 T 9 R 17W
BOOK PAGE 43 LINE 9