


Give All Information Completely
Make Required Affidavit
Mail or Deliver Report to:
Conservation Division
State Corporation Commission
800 Biffing Building
Wichita, Kansas

WELL PLUGGING RECORD

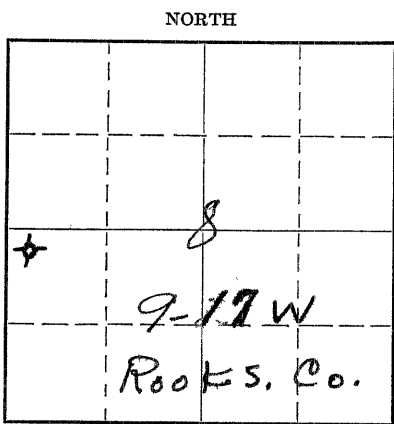

Locate well correctly on above Section Plat

Rooks County. Sec. 8 Twp. 9S Rge. 17W (W)
Location as "NE/CNW $\frac{1}{4}$ SW $\frac{1}{4}$ " or footage from lines NW-NW-SW
Lease Owner Madden, Mermis, Strain
Lease Name Hunter Well No. #1
Office Address Box 188, Hays, Kansas.
Character of Well (completed as ~~Oil, Gas~~ or Dry Hole) Dry Hole
Date well completed 11-24- 19 50
Application for plugging filed 11-24 19 50
Application for plugging approved 11-24 19 50
Plugging commenced 11-24 19 50
Plugging completed 11-24 19 50
Reason for abandonment of well or producing formation Dry Hole

If a producing well is abandoned, date of last production _____ 19 ____
Was permission obtained from the Conservation Division or its agents before plugging was commenced? yes Verbal

Name of Conservation Agent who supervised plugging of this well Eldon Petty
Producing formation _____ Depth to top _____ Bottom _____ Total Depth of Well 3535 Feet
Show depth and thickness of all water, oil and gas formations.

OIL, GAS OR WATER RECORDS

CASING RECORD

Formation	Content	From	To	Size	Put In	Pulled Out
<u>Shale & soil</u>		<u>0</u>	<u>150'</u>	<u>8 5/8"</u>	<u>150'</u>	<u>None</u>
<u>K.C.</u>		<u>3162</u>	<u>3398</u>		<u>Dry</u>	
<u>Arbuckle</u>		<u>3510</u>	<u>3535</u>		<u>Dry</u>	

Describe in detail the manner in which the well was plugged, indicating where the mud fluid was placed and the method or methods used in introducing it into the hole. If cement or other plugs were used, state the character of same and depth placed, from _____ feet to _____ feet for each plug set.

Stirred pits well, filled hole with heavy mud. Placed bottom wood plug at 145'. Ran 15 sacks cement, and one sack of hulls on same through drill pipe. Filled hole with heavy mud to 40'. Placed top wood plug and one sack hulls at 40'. Ran 10 sacks cement through drill pipe filling to bottom of cellar.

(If additional description is necessary, use BACK of this sheet)

Correspondence regarding this well should be addressed to Strain Drilling Company 11-28-1950
Address Box 188, Hays, Kansas.

STATE OF Kansas, COUNTY OF Ellis, ss.
T.C. Strain (employee of owner) or (owner or operator) of the above-described well, being first duly sworn on oath, says: That I have knowledge of the facts, statements, and matters herein contained and the log of the above-described well as filed and that the same are true and correct. So help me God.


(Signature) T.C. Strain

Box 188, Hays, Kansas.
(Address)

SUBSCRIBED AND SWORN TO before me this 27th day of November, 1950

Leroy R. Power
Notary Public.

My commission expires March 1, 1954

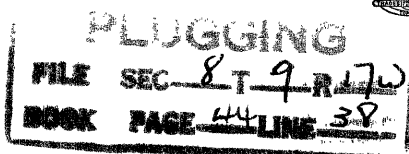

Well Log.

15-163-00310-00-00

Company: Walden, Permian.
 Lease: Hunter #1
 Elevation: 1987 Derrick floor.

NW-NW-SW Sec. 8, Twp. 25,
 Rge. 17W,
 Rooks County, Kansas.

Note: All measurements from rotary bushings.

0	50 Soil & clay
50	150 Shale & shells
150	650 Shale & shells
650	825 Sand & shale
825	885 Sandy lime.
885	845 Sandy lime, Pyrite
845	1050 Sand
1050	1250 Red bed.
1250	1325 Redbed & shale
1325	1365 Anhydrite
1365	1630 Shale & shells
1630	1900 Shale & shells
1900	2070 Shale & lime
2070	2210 Lime & shale
2210	2300 Lime & shale
2300	2330 Lime & shale
2330	2355 Lime
2355	2380 Lime & shale
2380	2525 Lime & shale
2525	2630 Lime & shale
2630	2715 Lime & shale
2715	2795 Lime & shale
2795	2895 Lime & shale
2895	2965 Lime & shale
2965	3045 Lime & shale
3045	3090 Lime & shale
3090	3125 Lime & shale
3125	3150 Lime
3150	3200 Lime
3200	3208 Lime
3208	3260 Lime
3260	3305 Lime
3305	3340 Lime
3340	3405 Lime
3405	3470 Lime & shale
3470	3515 Lime & chert
3515	3535 Lime
3535 (T.D.)	rotary bushing measurements.

COMMENCED: 11-14-50
 COMPLETED: 11-24-50

CASING RECORD:

Ø 5/8" Surface casing set at
 150' w/110 sacks cement. Cemented
 by Sun Cementing Co.

D.S.T. By Johnson Testing Co.

3200' - 3208' Tool open 1 hr.
 Recovered 115' muddy salt water.
 B.H.P. 15 min. 750#.

San Schlumberger log to total
 depth.

TOPS:

Topoka
 Hechler
 Trento
 Lansing

2902
 3121
 3199
 3162

Base K.C.
 Conglomerate
 Arbuckle
 T.D.

NOV 28 1950

3396
 3434
 3510
 3535

I hereby affirm that the above and foregoing is a true and correct
 copy of the log of the Hunter #1, located NW-NW-SW Sec. 8, Twp. 25, Rge. 17W,
 Rooks County, Kansas.

Contractors: Strain Drilling Company.

PLUGGING
 FILE SEC. P T 9 17W
 BOOK PAGE 48 LINE 29

By T.C. Strain
 T.C. Strain.