

15-163-00967-00-00

WELL PLUGGING RECORD


Give All Information Completely
Make Required Affidavit
Mail or Deliver Report to:
Conservation Division
State Corporation Commission
800 Bitting Building
Wichita, Kansas

Rooks

County. Sec. 8 Twp. 9S Rge. (E) 17 (W)

Location as "NE/CNW/SW" or footage from lines C-NE-NE-NW
Lease Owner Sunray Mid-Continent Oil Company
Lease Name Jackson Well No. 1
Office Address Box # 788, Great Bend, Kansas
Character of Well (completed as Oil, Gas or Dry Hole) Dry Hole
Date well completed May 26, 1956
Application for plugging filed May 28, 1956
Application for plugging approved May 29, 1956
Plugging commenced May 26, 1956
Plugging completed May 26, 1956
Reason for abandonment of well or producing formation _____

NORTH

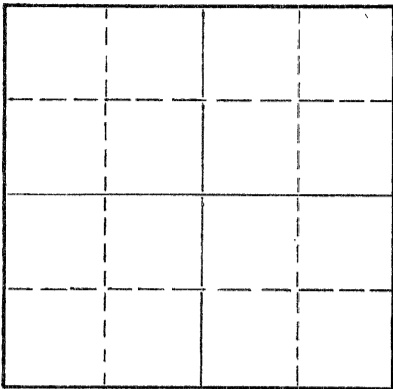

Locate well correctly on above
Section Plat

If a producing well is abandoned, date of last production _____ 19____
Was permission obtained from the Conservation Division or its agents before plugging was commenced? Yes

Name of Conservation Agent who supervised plugging of this well Eldon Petty
Producing formation _____ Depth to top _____ Bottom _____ Total Depth of Well 3450 Feet
Show depth and thickness of all water, oil and gas formations.

OIL, GAS OR WATER RECORDS

CASING RECORD

| FORMATION | CONTENT | FROM | TO | SIZE | PUT IN | PULLED OUT |
|-----------|---------|------|----|--------|--------|------------|
| | | | | 8 5/8" | 214' | None |
| | | | | | | |
| | | | | | | |
| | | | | | | |
| | | | | | | |
| | | | | | | |
| | | | | | | |
| | | | | | | |

Describe in detail the manner in which the well was plugged, indicating where the mud fluid was placed and the method or methods used in introducing it into the hole. If cement or other plugs were used, state the character of same and depth placed, from _____ feet to _____ feet for each plug set.

Filled Hole with drlg mud, set Halliburton wooden plug with 20 sacks of cement to 190'. Filled hole with drlg mud, set Halliburton wooden plug with at 40'. Dumped 15 sacks cement. Cement to surface. Plugging completed

(If additional description is necessary, use BACK of this sheet)

Name of Plugging Contractor Halliburton Oil Well Cementing Co.
Address _____

STATE OF KANSAS, COUNTY OF BARTON, ss.
Norman E. Montgomery (employee of owner) or (~~owner~~) of the above-described well, being first duly sworn on oath, says: That I have knowledge of the facts, statements, and matters herein contained and the log of the above-described well as filed and that the same are true and correct. So help me God.

(Signature) Norman E. Montgomery
Box # 788, Great Bend, Kansas
(Address)

SUBSCRIBED AND SWORN TO before me this 7 day of June, 1956

My commission expires Dec. 24, 1956

H. H. H. H.

RECEIVED Notary Public.
JUN 8 1956
06-08-1956
CONSERVATION DIVISION
WICHITA, KANSAS

PLUGGING
FILE SEC 8 T 9 R 17W
BOOK PAGE 65 LINE 41

15-163-00967-00-00

Sunray Mid-Continent Oil Co.
Tulsa, Oklahoma

Tulsa, Oklahoma
May 31, 1956

CONTRACTOR: Stickle Drilling Company
Drilling Commenced: May 14, 1956
Drilling Completed: May 26, 1956

Jackson #1, NE NE NW of
Section 8-9S-17W, Rooks
County, Kansas.

DRILLERS LOG

Depth Figures Indicate Base of Formation

| | |
|----------------------|---------|
| Shale & Shells | 80 |
| Sand & Iron | 90 |
| Shale | 216 |
| Shale & Shells | 530 |
| Sand | 590 |
| Red Bed & Shale | 1050 |
| Shale & Shells | 1310 |
| Anhydrite | 1340 |
| Shale & Shells | 1625 |
| Shale & Lime Shells | 1845 |
| Lime & Shale | 2285 |
| Shale & Lime | 2445 |
| Shale & Lime Streaks | 2560 |
| Lime & Shale | 2630 |
| Shale & Lime | 2825 |
| Lime & Shale | 3135 |
| Lime | 3365 |
| Lime & Shale | 3413 |
| Lime | 3425 |
| Lime & Dolomite | 3436 |
| Arbuckle | 3450 TD |

I, Frank E. Stickle, hereby certify the above to be a true and correct Driller's Log of Sunray Mid-Continent Oil Company's Jackson #1, NE NE NW, of Section 8-9S-17W, Rooks County, Kansas.

Frank E. Stickle
Frank E. Stickle

Lillian T. Bonham
Notary Public

February 13, 1960
My Commission Expires

PLUGGING
FILE SEC 8 T 9 R 17W
BOOK PAGE 65 LINE 41

RECEIVED
STATE OF OKLAHOMA
COMMISSION
JUN 1 1956
CONSULTING