

STATE OF KANSAS  
STATE CORPORATION COMMISSION

Give All Information Completely  
Make Required Affidavit  
Mail or Deliver Report to:  
Conservation Division  
State Corporation Commission,  
800 Biting Building,  
Wichita, Kansas

07/23/37  
RECEIVED  
JUL 23 1937  
K

15-163-04129-00-00  
WELL PLUGGING RECORD

OR  
FORMATION PLUGGING RECORD

Strike out upper line  
when reporting plugging  
off formations.

Rooks County, Kansas County. Sec. 9 Twp. 9S Rge. 17 (W)

Location as "NE 1/4 NW 1/4 SW 1/4" or footage from lines

Lease Owner Phillips Petroleum Co.

Lease Name Manquist Well No. #1

Office Address Great Bend, Kansas

Character of Well (Completed as Oil, Gas or Dry Hole) Dry Hole

Date, well completed June 28, 1937 19

Application for plugging filed 6-30 1937

Application for plugging approved 7-1 1937


Plugging Commenced 7-3 1937

Plugging Completed 7-12 1937

Reason for abandonment of well or producing formation Dry Hole

If a producing well is abandoned, date of last production 193

Was permission obtained from the Conservation Division or its agents before plugging was commenced? Yes

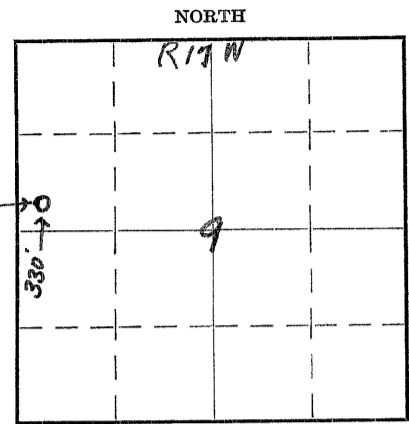

Locate well correctly on above  
Section Plat

Name of Conservation Agent who supervised plugging of this well Alexander

Producing formation Depth to top Bottom Total Depth of Well 3515 Feet

Show depth and thickness of all water, oil and gas formations.

OIL, GAS OR WATER RECORDS

CASING RECORD

Formation	Content	From	To	Size	Put In	Pulled Out
Surface Pipe cemented to top	500 sx cement			18 1/2	1006	left in
				8 5/8	3229	2670
Oswald Lime Cemented	50 sx cement	3225				
Siliceous Lime		3505	3515	T.D.		
Hole full water from		3512	3515			

Describe in detail the manner in which the well was plugged, indicating where the mud fluid was placed and the method or methods used in introducing it into the hole. If cement or other plugs were used, state the character of same and depth placed, from feet to feet for each plug set.

Hole was plugged with heavy rotary mud. Filled to 250' from top. 12 sx cement set at 250'. Filled to top with rotary mud and 15 sx cement put in top of surface pipe and cellar

PLUGGING  
FILE NO. 9 9 17W  
BOOK PAGE 96 LINE 29

(If additional description is necessary use BACK of this sheet)

Correspondence regarding this well should be addressed to F. W. Shelton  
Address Below

STATE OF Kansas, COUNTY OF Sedgewick, SS.

F. W. Shelton (employee of owner) or (owner or operator) of the above-described well, being first duly sworn on oath, says: That I have knowledge of the facts, statements, and matters herein contained and the log of the above-described well as filed and that the same are true and correct. So help me God.

(Signature) F. W. Shelton  
1319 Main St. Great Bend, Kans.  
(Address)

SUBSCRIBED AND SWORN to before me this 22 day of July, 1937.


My commission expires April 24, 1940. M. A. Miles  
Notary Public.

15-163-64129-CO-CO

FORMATION RECORD - Manquist No. 1

From	To	Kind
0	23	Surface Clay
23	235	Lime & shells
235	260	Shale
260	485	Shells & shale
485	500	Sand
500	610	Shale & shells
610	635	Broken lime & shale
635	643	Hard lime
643	655	Sand
655	815	Shale
815	838	Lime & shale
838	1025	Sand & lime
1025	1050	Lime
1050	1060	Shale
1060	1080	Hard sand
1080	1100	Lime
1100	1348	Red bed
1348	1380	Anhydrite
1380	1390	Lime
1390	1550	Red bed & shells
1550	1780	Shale & shells
1780	1785	Lime
1785-	1795	Shells & shale
1795	1845	Red rock & lime
1845	1870	Lime
1870	1930	Shale
1930	1980	Broken lime & shale
1980	1985	Salt
1985	2000	Shells & shale
2000	2055	Lime
2055	2095	Red rock & lime
2095	2170	Shale
2170	2177	Hard lime
2177	2235	Shale & shells
2235	2252	Lime & red rock
2252	2257	Shale
2257	2274	Red rock & lime
2274	2296	Shale & shells

6/1/38

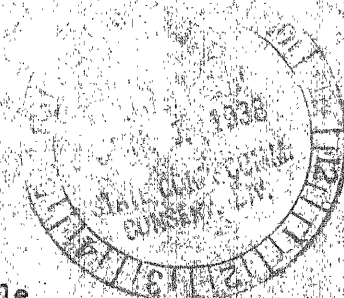

PLUGGING  
FILE 9.9-1210  
BOOK PAGE 96 LINE 29

15-163-04129-00-00

2296	2355	Red rock & shale
2355	2374	Broken lime
2374	2408	Red rock & shale
2408	2480	Lime
2480	2485	Red rock
2485	2916	Lime, shale & shells
2916	2936	Red rock & shells
2936	2945	Lime
2945	2965	Shale
2965	3191	Lime
3191	3225	Shale & broken lime
3225	3255	Lime
3255	3260	Shale
3260	3276	Lime
3276	3278	Soft shale
3278	3281	Lime
3281	3283	Shale
3283	3325	Lime
3325	3327	Red rock
3327	3333	Shale
3333	3436	Lime
3436	3445	Shale
3445	3448	Lime
3448	3452	Shale, blue
3452	3461	Lime
3461	3465	Shale, red
3465	3468	Lime
3468	3470	Shale, red
3470	3477	Lime
3477	3485	Shale, caving
3485	3489	Broken lime
3490	3504	Shale, various
3504	3515	Lime, siliceous T.D.

DRY HOLE - Plugged & abandoned.

