


STATE OF KANSAS
STATE CORPORATION COMMISSION

Give All Information Completely
Make Required Affidavit
Mail or Deliver Report to:
Conservation Division
State Corporation Commission
211 No. Broadway
Wichita, Kansas

15-163-02808-00-00
WELL PLUGGING RECORD

NORTH

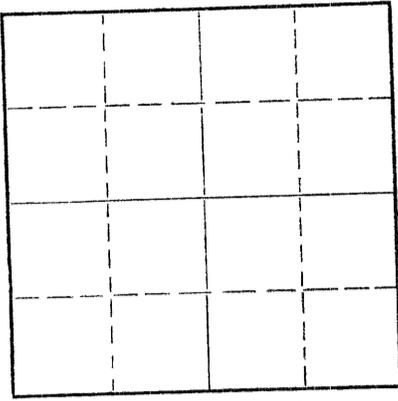

Locate well correctly on above
Section Plat

Rooks County. Sec. 9 Twp. 9S Rge. 17W (E) (W)

Location as "NE/CNW/SW" or footage from lines SE SE NW

Lease Owner Osage Oil & Gas Co. - Sierra Petroleum Co., Inc.

Lease Name MAINQUIST B Well No. 1

Office Address 709 Petroleum Bldg., Wichita, Ks/ 208 Petro Bldg., Wichita

Character of Well (completed as Oil, Gas or Dry Hole) Dry Hole

Date well completed 10/5/57 19

Application for plugging filed 10/4/57 19

Application for plugging approved 10/4/57 19

Plugging commenced 10/5/57 19

Plugging completed 10/5/57 19

Reason for abandonment of well or producing formation dry

If a producing well is abandoned, date of last production 19

Was permission obtained from the Conservation Division or its agents before plugging was commenced? yes

Name of Conservation Agent who supervised plugging of this well Mr. Eldon Petty
Producing formation Depth to top Bottom Total Depth of Well 3520 Feet

Show depth and thickness of all water, oil and gas formations.

OIL, GAS OR WATER RECORDS

CASING RECORD

| FORMATION | CONTENT | FROM | TO | SIZE | PUT IN | PULLED OUT |
|-----------|---------|------|----|-------|--------|---------------------|
| | | | | 8 5/8 | 182 | XXX none |
| | | | | | | |
| | | | | | | |
| | | | | | | |
| | | | | | | |
| | | | | | | |
| | | | | | | |

Describe in detail the manner in which the well was plugged, indicating where the mud fluid was placed and the method or methods used in introducing it into the hole. If cement or other plugs were used, state the character of same and depth placed, from feet to feet for each plug set.

PLUGGING RECORD

Filled hole with heavy mud from 3520 up to 600'. Set plug with 20 sks cement through drill pipe. Filled hole with heavy mud up to 175'. Set bridge w/wood plug 1/3 sack hulls 15 sacks cement through drill pipe. Filled hole up to 40' with heavy mud. Set bridge with wood plug 1/2 sack hulls. 10 sks cement to cellar.

(If additional description is necessary, use BACK of this sheet)

Name of Plugging Contractor Sierra Petroleum Co., Inc.
Address 208 Petroleum Bldg., Wichita, Kansas

STATE OF KANSAS, COUNTY OF RUSSELL, ss.
C. T. Honaker (employee of owner) or (owner or operator) of the above-described well, being first duly sworn on oath, says: That I have knowledge of the facts, statements, and matters herein contained and the log of the above-described well as filed and that the same are true and correct. So help me God.

(Signature) C. T. Honaker

(Address)

SUBSCRIBED AND SWORN TO before me this 7th day of October, 1957

Margie Cooper

Notary Public.

My commission expires 1-30-61.

OCT 8 1957
CONSERVATION
Wichita, Kansas

PLUGGING
FILE SEC 9 T 9 R 17W
BOOK PAGE 51 LINE 28

15-443-02808-0200

Owner: Oaage Oil & Gas Co

Contr: Sierra Petroleum Co.

MAINQUIST B #1

SE SE NW Sec. 9-9S-17W
Rooks County, Kansas

Total Depth: 3520'

Elev: 2060 KB

Comm: 9/27/57

Comp: 10/5/57

Casings:

Cement:

8 5/8 @ 182'

with 125 sks cement

| FORMATION | DEPTH |
|------------------------|-------|
| Surface clay | 40 |
| Sand & shale | 125 |
| Shale & shells | 182 |
| Shale | 405 |
| Shale & shells | 525 |
| Sand, shale & red bed | 900 |
| Sand, shale & shells | 1320 |
| Red bed | 1360 |
| Anhydrite | 1400 |
| Shale, shells & pyrite | 1670 |
| Shale & shells | 1720 |
| Shale & salt | 1815 |
| Lime & shale | 3085 |
| Lime | 3152 |
| Lime & shale | 3214 |
| Lime | 3447 |
| Congl | 3470 |
| Arbuckle | 3520 |

| | |
|---------------|------|
| Tops: Topeka | 2945 |
| Heebner | 3162 |
| Lansing K. C. | 3204 |
| Arbuckle | 3483 |

STATE OF KANSAS)
) ss:
COUNTY OF RUSSELL)

I hereby certify that the above information is true and correct to the best of my knowledge.

O P Honaker

Subscribed and sworn to before me this 7th day of October, 1957.

Margie Cooper
Notary Public

My commission expires: 1-30-61.

RECEIVED
STATE CORPORATION COMMISSION
OCT 8 1957
CONSERVATION DIVISION
Wichita, Kansas

PLUGGING
FILE SEC 9 (9 R 17W
BOOK PAGE 51 LINE 28