


STATE OF KANSAS
STATE CORPORATION COMMISSION

Give All Information Completely
Make Required Affidavit
Mail or Deliver Report to:
Conservation Division
State Corporation Commission
211 No. Broadway
Wichita, Kansas

15-163-04138-00-0 Form CP-4

WELL PLUGGING RECORD

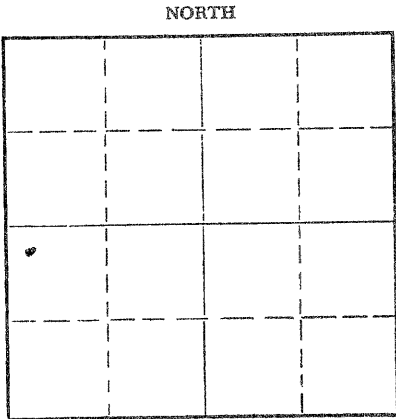

Locate well correctly on above Section Plat

ROOKS County, Sec. 12 Twp 9S Rge 7W (E) (W)
Location as "NE/CNW/SW" or footage from lines NW NW SW
Lease Owner ATLANTIC RICHFIELD COMPANY
Lease Name Robert J. McClay Well No. 1
Office Address 1112 11th, Woodward, Oklahoma 73801
Character of Well (completed as Oil, Gas or Dry Hole) Oil
Date well completed October 19 37
Application for plugging filed 5-6- 19 76
Application for plugging approved 19
Plugging commenced 5-10- 19 76
Plugging completed 5-11- 19 76
Reason for abandonment of well or producing formation Dakota water leak -
Injection well - Recommend P & A
If a producing well is abandoned, date of last production 19
Was permission obtained from the Conservation Division or its agents before plugging was commenced? Yes

Name of Conservation Agent who supervised plugging of this well State Plugging Agent - Hays, Ks was present
Producing formation Lansing, KC Depth to top 3148 Bottom 3299 Total Depth of Well 3340 Feet
Show depth and thickness of all water, oil and gas formations.

OIL, GAS OR WATER RECORDS				CASING RECORD		
FORMATION	CONTENT	FROM	TO	SIZE	PUT IN	PULLED OUT
Lansing, KC		Surface	109	10 3/4	109	None
	Oil	Surface	3150	RKB 7"	3150 RKB	None
	Oil (liner)	3132	3311	5 1/2	179	None
		Surface	3129	5 1/2	3129	None

Describe in detail the manner in which the well was plugged, indicating where the mud fluid was placed and the method or methods used in introducing it into the hole. If cement or other plugs were used, state the character of same and depth placed, from feet to feet for each plug set.

Ran 48 jt 2 7/8" tubing, open end 1543'. Pump water to get injection rate on vacuum. Spot 25 sks common cement 2% cal chl w/1/4 bbl flo seal per sack on vacuum. Mix 1/2 sack cottonseed hulls & 2 sacks gel and spot 25 sks common cement 2% cal chl w/1/4 bbl flo seal per sack well on vacuum. Waited 20 min. mixed 1 1/2 sks cottonseed hulls 10 sks gel and 50 sks common cement 2% cal chl w/1/4 bbl flo seal per sack; spotted at 1543' fluid dropping very slowly. Wait 2 1/2 hrs circulated 30 sks gel 5 sks hulls well not on vacuum. Spotted 50 sks common cement 2% cal cho w/1/4 bbl flo seal per sack. No vacuum at 1543'. Spot 50 sks common cement 2% cal chl 1/4 bbl flo seal per sack at 600 ft. Cement stood at 100 ft from surface. Made impression block and dent plug at 100 ft and filled to surface with cement.

(If additional description is necessary, use BACK of this sheet)

Name of Plugging Contractor ATLANTIC RICHFIELD COMPANY
Address 1112 11th, Woodward, Oklahoma 73801

STATE OF OKLAHOMA, COUNTY OF WOODWARD, ss.

(employee of owner) or (owner or operator) of the above-described well, being first duly sworn on oath, says: That I have knowledge of the facts, statements, and matters herein contained and the log of the above-described well as filed and that the same are true and correct. So help me God.

(Signature) *Donald T. Jenkins*

1112 11th, Woodward, Oklahoma 73801
(Address)

SUBSCRIBED AND SWORN to before me this 21 day of May, 19 76

Donna Hale
DONNA HALE

Notary Public.

My commission expires 2-28-79