


15-163-19235-00-00

WELL PLUGGING RECORD

Give All Information Completely
Make Required Affidavit
Mail or Deliver Report to:
Conservation Division
State Corporation Commission
800 Bitting Building
Wichita, Kansas

Rooks County. Sec. 12 Twp. 9 Rge. 17 (E) (W)
Location as "NE/CNW/SW" or footage from lines S₂T₉R₁₇
Lease Owner Plainstock Oil and Gas Co.,
Lease Name Plainstock Oil & Gas Co.-Smith Well No. 1
Office Address Plainville, Kansas
Character of Well (completed as Oil, Gas or Dry Hole) Oil
Date well completed 12/4/39
Application for plugging filed July 22 19 55
Application for plugging approved July 22 19 55
Plugging commenced July 26 19 55
Plugging completed August 5 19 55
Reason for abandonment of well or producing formation 100% water

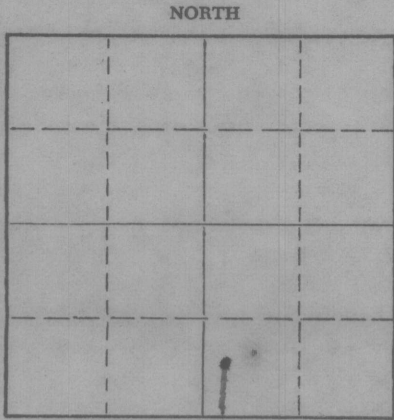

Locate well correctly on above Section Plat

If a producing well is abandoned, date of last production July 19 54
Was permission obtained from the Conservation Division or its agents before plugging was commenced? Yes.

Name of Conservation Agent who supervised plugging of this well Eldon Petty
Producing formation Kansas City Depth to top 3167 Bottom 3420 Total Depth of Well 3420 Feet
Show depth and thickness of all water, oil and gas formations.

OIL, GAS OR WATER RECORDS

CASING RECORD

FORMATION	CONTENT	FROM	TO	SIZE	PUT IN	PULLED OUT
		0	3169	7"	3169	1019
<u>Kansas City</u>		<u>3167</u>	<u>3420</u>	<u>5 1/2</u>	<u>255</u>	<u>None</u>

Describe in detail the manner in which the well was plugged, indicating where the mud fluid was placed and the method or methods used in introducing it into the hole. If cement or other plugs were used, state the character of same and depth placed, from 3420 feet to surface feet for each plug set.

Hole cleaned out and hole filled with sand from 3420 to 3390 ft;
Three sacks of cement placed in hole with dump bailer, forming cement plug from 3390 to 3366 ft; Rock bridge set at 3167, to 3160 ft;
five sacks of cement placed in hole with dump bailer to form cement plug from 3160 to 3135 ft; Hole filled with mud from 3135 ft to 160 feet; ten foot rock bridge installed between 160 and 150 ft.
Twenty sacks of cement poured in hole to form cement bridge from 150 ft to 110 feet; Hole filled with mud to 30 feet; ten foot rock bridge installed between 30 and 20 feet; hole capped with ten sacks of cement.

(If additional description is necessary, use BACK of this sheet)

Name of Plugging Contractor Barnes and Sons Pipe Pulling Co
Address Russell, Kansas.

STATE OF KANSAS, COUNTY OF ROOKS, ss.
C. C. Reeves

(employee of owner) or (owner or operator) of the above-described well, being first duly sworn on oath, says: That I have knowledge of the facts, statements, and matters herein contained and the log of the above-described well as filed and that the same are true and correct. So help me God.

(Signature) C. C. Reeves

Plainville, Kansas
(Address)

SUBSCRIBED AND SWORN TO before me this 9th day of August, 1955

My commission expires Sept. 28, 1955

Betha A. Wise
Notary Public.

PLUGGING
FILE SEC 12 T 9 R 17W
BOOK PAGE 141 LINE 9

RECEIVED
STATE CORPORATION COMMISSION
AUG 11 1955
CONSERVATION DIVISION
Wichita, Kansas

SANDS PETROLEUM CORPORATION.
Dora Smith No. 1.


SEC. 12 T. 9 R. 17W.
CWL SW SE

15-163-19235-0000

~~15-163-71144~~

Total Depth. 3420
Comm. 11-21-39 Comp. 12-14-39
Shot or Treated.
Contractor.
Issued. 12-7-40 Rotary

County Rooks.

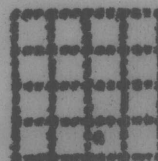

CASING.

103/4" 30" 7" 3169'

Elevation.

Production. Pot. 69 B.

Figures Indicate Bottom of Formations.

sand and shale	215	lime Kansas City	3220
shale and shells	585	lime	3227
shale and lime	800	lime hard	3230
salt	1070	lime broken	3235
lime and shale	1285	lime	3245
lime	1310	lime hard	3247
lime broken	1450	lime soft	3249
shale	1485	lime hard	3250
lime and shale	1565	lime	3259
lime and salt	1662	lime hard	3270
shale and lime broken	1740	lime	3279
shale	1785	shale grey	3285
lime and shale	1894	lime	3308
shale	1940	lime hard	3309
lime	1955	lime softer	3312
shale	1975	lime hard	3313
lime	2050	shale grey with red and green streaks	3420
lime and shale	2110		
lime and chert strks	2130		
shale	2158	Total Depth.	
lime	2180		
lime broken	2203		
shale	2223		
lime	2279		
lime and broken shale	2346		
lime and shale	2408		
lime	2444		
lime and shale	2454		
shale and gumbo	2488		
lime	2501		
shale	2515		
shale and lime	2560		
broken lime	2585		
red bed	2593		
broken lime and shale	2650		
shells and shale	2708		
broken shells & shale	2745		
shale	2770		
broken lime	2800		
shale	2815		
shale and lime	2910		
lime	3037		
shale	3058		
lime	3098		
lime and shale	3125		
shale	3135		
shale and lime cored	3158		
shale and lime	3169		
lime	3171		
lime broken	3183		
shale blue and shells	3191		
lime	3208		
broken lime and variegated shale	3210		

PLUGGING
WELL SEC. 12 T. 9 R. 17W
BOOK PAGE 141 LINE 9

12	10	9	9	10	
30-	29-5	28-2	29-4	27-10	29-8
30-9	29-4	28-3	29-5	29-	28-10
27-10	29-9	28-9	28-4	29-7	29-2
28-9	29-6	29-7	27-10	29-9	29-8
28-5	29-8	29-10	29-	29-2	29-2
29-7	29-	29-	30-	29-9	14-2
29-4	28-11	29-8	29-	28-8	8
28-5	29-10	29-8	29-	29-9	6
28-10	29-9	29-10	28-3	29-8	
27-10	29-3	29-	29-10	28-8	
29-	29-4	28-9	29-7	29-8	
28-11	29-	29-	28-	28-9	
29-4	29-7	29-6	29-10	29-2	
29-9	29-9	28-8	29-7		
28-11	29-8	28-2	28-		
29-7	29-8	28-2	29-10		
28-11	29-2	29-9	28-4	29-7	-9
28-4	28-	28-7	29-9	29-	8/10 = 36 - 87
28-5	28-9	28-8	28-6	29-1	
27-11	29-6	28-7	29-3	29-1	
636-1	29-8	29-	29-3	33-	129.41
	29-4		28-11	28-10	48.17
			28-2	29-9	131.24
636-1	644-5	580-5	29-8	28-3	33.
			28-10	28-10	24/164
			9-1	13.0	
			10-10		
			637-1	644 10	

- 636-1
- 644-2
- 580-5
- 637-1
- 644-10
- 174-8

1727
23

3317-3
3420
3165
255

3392 7.0.

17109

3220
3169
255

127/8225
127/8225
127/8225

88
304
2245
3369-4
23
5392-4