


Give All Information Completely  
Make Required Affidavit  
Mail or Deliver Report to:  
Conservation Division  
State Corporation Commission  
212 North Market, Insurance Bldg.  
Wichita, Kansas

15-163-19242-00-01

WELL PLUGGING RECORD

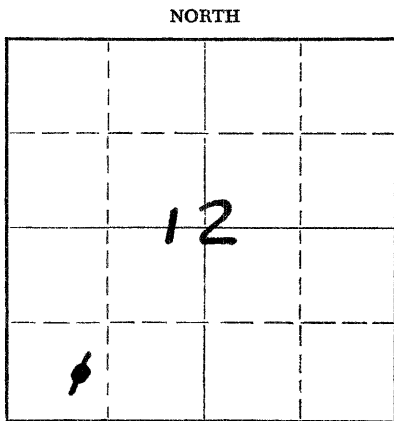

Locate well correctly on above  
Section Plat

Rooks \_\_\_\_\_ County. Sec. 12 Twp. 9 Rge. (E) 17 (W) \_\_\_\_\_  
Location as "NE/CNW/SW" or footage from lines E/2 SW SW  
Lease Owner Cooperative Refinery Association  
Lease Name McClay Well No. 1  
Office Address Drawer "C", Great Bend, Kansas  
Character of Well (completed as Oil, Gas or Dry Hole) Oil  
Date well completed September 4, 1941  
Application for plugging filed January 30, 1964  
Application for plugging approved Verbal approval January 28, 1964  
Plugging commenced January 28, 1964  
Plugging completed January 28, 1964  
Reason for abandonment of well or producing formation \_\_\_\_\_  
Casing failure-could not repair  
If a producing well is abandoned, date of last production May 1, 1957  
Was permission obtained from the Conservation Division or its agents before plugging was commenced? Yes

Name of Conservation Agent who supervised plugging of this well Eldon Petty  
Producing formation Lansing-Kansas City Depth to top 3174 Bottom 3347 Total Depth of Well 3347 Feet  
Show depth and thickness of all water, oil and gas formations.

OIL, GAS OR WATER RECORDS

CASING RECORD

FORMATION	CONTENT	FROM	TO	SIZE	PUT IN	PULLED OUT
Limestone	Oil	3174	3347	8 5/8	95	None
				5 1/2	3185	None

Describe in detail the manner in which the well was plugged, indicating where the mud fluid was placed and the method or methods used in introducing it into the hole. If cement or other plugs were used, state the character of same and depth placed, from \_\_\_\_\_ feet to \_\_\_\_\_ feet for each plug set.

Ran 2 1/2" tubing to 924 feet. Spotted 50 sacks of HA-5 cement from 924 feet to 524 feet. Pulled tubing to 430 feet and spotted 25 sacks of cement from 430 feet to 140 feet. Pulled tubing to 140 feet and circulated cement to surface. Laid rig down.

RECEIVED  
STATE CORPORATION COMMISSION

JAN 31 1964

CONSERVATION DIVISION  
Wichita, Kansas

(If additional description is necessary, use BACK of this sheet)

Name of Plugging Contractor \_\_\_\_\_  
Address \_\_\_\_\_

STATE OF Kansas, COUNTY OF Barton, ss.  
Paul M. Goodwin (employee of owner) or (owner or operator) of the above-described

well, being first duly sworn on oath, says: That I have knowledge of the facts, statements, and matters herein contained and the log of the above-described well as filed and that the same are true and correct. So help me God.

(Signature) Paul M. Goodwin  
Drawer "C", Great Bend, Kansas (Address)

SUBSCRIBED AND SWORN TO before me this 29th day of January, 1964

My commission expires April 17, 1966

Notary Public

