


STATE OF KANSAS
STATE CORPORATION COMMISSION

15-163-00547-00-00
WELL PLUGGING RECORD

Give All Information Completely
Make Required Affidavit
Mail or Deliver Report to:
Conservation Division
State Corporation Commission
800 Bitting Building
Wichita, Kansas

NORTH

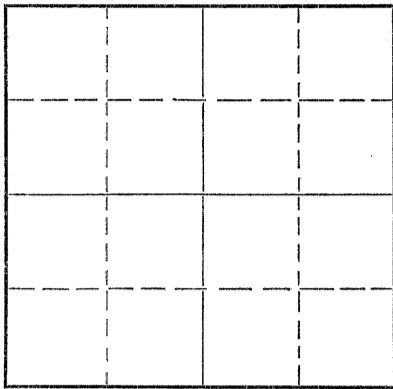

Locate well correctly on above
Section Flat

Rooks _____ County. Sec. 10 Twp. 9 Rge. 17 (E) W. (W)
Location as "NE/CNW $\frac{1}{4}$ SW $\frac{1}{4}$ " or footage from lines NW NW NE
Lease Owner Mallonee Drilling Company, Inc.
Lease Name Carmichael Well No. 1
Office Address 812 Central Bldg., Wichita, Kansas
Character of Well (completed as Oil, Gas or Dry Hole) Dry Hole
Date well completed July 3 19 53
Application for plugging filed July 3 19 53
Application for plugging approved July 3 19 53
Plugging commenced July 3 19 53
Plugging completed July 3 19 53
Reason for abandonment of well or producing formation Dry Hole

If a producing well is abandoned, date of last production None 19 ____
Was permission obtained from the Conservation Division or its agents before plugging was commenced? Yes

Name of Conservation Agent who supervised plugging of this well Eldon Petty
Producing formation _____ Depth to top _____ Bottom _____ Total Depth of Well 3495 Feet
Show depth and thickness of all water, oil and gas formations.

OIL, GAS OR WATER RECORDS

CASING RECORD

Formation	Content	From	To	Size	Put In	Pulled Out
				8-5/8	170'	Cement circulated to surface

Describe in detail the manner in which the well was plugged, indicating where the mud fluid was placed and the method or methods used in introducing it into the hole. If cement or other plugs were used, state the character of same and depth placed, from _____ feet to _____ feet for each plug set.

Hole filled with mud to 160 ft. by pumping through drill pipe.
Halliburton plug set at 160'. Halls placed on top of Halliburton plug. 15 sacks of mixed cement placed on top of plug. Hole filled to mud to 40 ft. Halliburton plug and halls set at 40 ft. Ten sacks of mixed cement placed from 38 ft. to surface.

RECEIVED
STATE CORPORATION COMMISSION
CONSERVATION DIVISION
WICHITA, KANSAS
7/9/53

(If additional description is necessary, use BACK of this sheet)

Correspondence regarding this well should be addressed to Mallonee Drilling Company, Inc.
Address 812 Central Bldg., Wichita 2, Kansas

STATE OF Kansas, COUNTY OF Sedgwick, ss.
F. W. Mallonee (employee of owner) or (owner or operator) of the above-described well,
being first duly sworn on oath, says: That I have knowledge of the facts, statements, and matters herein contained and the log of the above-described well as filed and that the same are true and correct. So help me God.

(Signature) F. W. Mallonee
812 Central Bldg., Wichita, Kansas
(Address)

SUBSCRIBED AND SWORN to before me this 7th day of July, 19 53
F. E. Mallonee
Notary Public.

My commission expires March 7, 1957

PLUGGING
FILE SEC 10 T 9 R 170
BOOK PAGE 112 LINE 28

15-163-00547-0500

DRILLER'S LOG
MALLONEE DRILLING COMPANY
#1 CARMICHAEL
NW NW NE SEC. 10-9-17W
ROOKS COUNTY, KANSAS

Commenced: 6-22-53
Completed: 7-3-53
Operator: Mallonee Drilling Company, Inc.

Elev. 2022 KB
Prod: D & A

FROM	TO	DESCRIPTION	REMARKS
0	80	Clay and sand streaks	
80	150	Shale and shells	
150	168	Lime and shell	170' (5 jts.) 8-5/8" surface casing set at 168' with 85 sks cement and 1 c.c.
168	770	Shale and shells	
770	885	Shale	
885	1035	Sand and shale	
1035	1300	Red bed and shale	
1300	1310	Shale	
1310	1365	Lime	
1365	1510	Shale	
1510	1750	Shale, shells and salt	
1750	1935	Shale and lime shells	
1935	1980	Shale and lime streaks	
1980	2055	Shale	
2055	2115	Lime	
2115	2305	Lime and shale	
2305	2360	Lime	
2360	2370	Shale	
2370	2410	Lime	
2410	2550	Lime and shale	
2550	2575	Shale	
2575	3400	Lime	
3400	3445	Lime and shale	
3445	3495	Arbuckle	

TOPS:			
Anhydrite	1310-	* 712	
Heebner	3132	-1110	
Toronto	3154	-1132	
Lansing	3176	-1154	
Arbuckle	3465	-1443	
Total Depth	3495	-1473	

I certify that to the best of my knowledge and belief, the above represents a true and accurate Driller's Log record of the above captioned well.

R. E. Mallonee

PLUGGING
FILE SEC 10 T 9 R 17W
BOOK PAGE 112 LINE 28

RECEIVED
JUL 9 1953
OPERATION DIVISION
Wichita, Kansas
7/9/53