


Give All Information Completely
Make Required Affidavit
Mail or Deliver Report to
Conservation Division
State Corporation Comm.
200 Colorado Derby Bldg.
202 W. 1st St.
Wichita, KS 67202

Rooks County Sec. 10 Twp. 9S Rge. 17W
Location as "NE/CNW/SW" or footage from lines
SE SE SE

Lease Owner Oil Property Management, Inc.
Lease Name Oswald "B" Well No #2
Office Address 221 N. Main Suite 200 Wichita, Ks 67202
Character of Well (Completed as Oil, Gas or Dry Hole) Dry Hole

Date Well completed 12-19 19 83
Application for plugging filed 12-19 19 83
Application for plugging approved 12-19 19 83
Plugging commenced 5:00 P.M. 12-19 19 83
Plugging completed 10:00 P.M. 12-19 19 83
Reason for abandonment of well or producing formation No Commercial Production

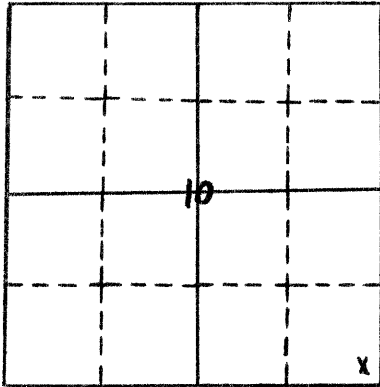

locate well correctly
on above
Section Plot

If a producing well is abandoned, date of last production 19

Was permission obtained from the Conservation Division
its agents before plugging was commenced? Yes

Name of Conservation Agent who supervised plugging of this well Marion Schmidt
Producing formation Depth to top Bottom Tl. Depth of Well
Show depth and thickness of all water, oil and gas formations.

OIL, GAS OR WATER RECORDS

CASING RECORD

FORMATION	CONTENT	FROM	TO	SIZE	PUT IN	PULLED OUT
Surface Casing	common	0'	240.59'	8 5/8"	240.59'	0'

Describe in detail the manner in which the well was plugged, indicating where the mud fluid was placed and the method or methods used in introducing it into the hold. If cement or other plugs were used, state the character of same and depth placed, from feet to feet for each plug set.

- Plug #1 3450' with 20sxs
- Plug #2 1270' with 20sxs
- Plug #3 733' with 80sxs
- Plug #4 290' with 40sxs
- Plug #5 40' with 10sxs

10sxs in rathole


12-19-83 P.D. @ 10:00 P.M. TOTAL:-----180sxs 50-50pos 4%gel 3%cc

(If additional description is necessary, use BACK of this sheet)

Name of Plugging Contractor PIONEER DRILLING COMPANY, INC.
308 West Mill Plainville, KS 67663

STATE OF Kansas COUNTY OF Sedgwick, ss.

W. H. Peachee (employee or owner or owner or operator) of the above described well, being first duly sworn on oath, says: That I have knowledge of the facts, statements, and matters herein contained and the log of the above described well is filed and that the same are true and correct. So help me God.

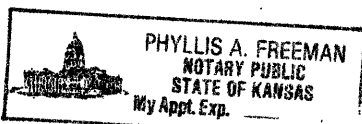

(Signature) W. H. Peachee
W. H. Peachee
(Address) 221 N. Main, Suite 200, Wichita, 67202

SUBSCRIBED AND SWORN TO before me this 27th day of December, 19 83

My commission expires 6-9-86

Phyllis A. Freeman
Notary Public
Phyllis A. Freeman

RECEIVED
STATE CORPORATION COMMISSION
DEC 28 1983
CONSERVATION DIVISION
Wichita, Kansas
12/20/83