

STATE OF KANSAS
STATE CORPORATION COMMISSION


WELL PLUGGING RECORD

Give All Information Completely
Make Required Affidavit
Mail or Deliver Report to:
Conservation Division
State Corporation Commission
800 Biting Building
Wichita, Kansas

OR
FORMATION PLUGGING RECORD

Strike out upper line
when reporting plug-
ging off formations.

NORTH

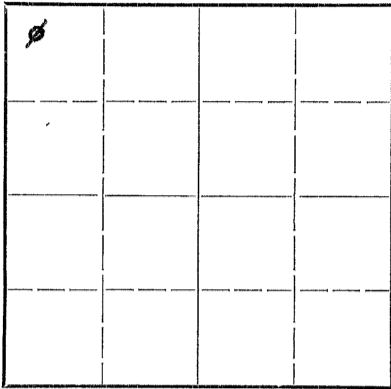

Locate well correctly on above
Section Plat

Boaks County. Sec. 11 Twp. 9 S. Rge. 17 (E) W (W)
Location as "NE $\frac{1}{4}$ NW $\frac{1}{4}$ SW $\frac{1}{4}$ " or footage from lines. C. NW $\frac{1}{4}$ NW $\frac{1}{4}$ NW $\frac{1}{4}$
Lease Owner. Delta Production Co
Lease Name. Westhusin Well No. 1
Office Address. 523 Union Nat'l. Bank Bldg., Wichita, Kans.
Character of Well (completed as Oil, Gas or Dry Hole) Dry Hole
Date well completed. Jan 8, 1948 19
Application for plugging filed. 19
Application for plugging approved. Jan 15, 1948 19
Plugging commenced. Jan 9, 1948 19
Plugging completed. Jan 9, 1948 19
Reason for abandonment of well or producing formation. Dry
If a producing well is abandoned, date of last production. — 19
Was permission obtained from the Conservation Division or its agents before plugging was com-
menced? Yes

Name of Conservation Agent who supervised plugging of this well. C. B. Staugh, State Pluggor
Producing formation. Depth to top. Bottom. Total Depth of Well. 346.6 Feet
Show depth and thickness of all water, oil and gas formations.

OIL, GAS OR WATER RECORDS

CASING RECORD

Formation	Content	From	To	Size	Put In	Pulled Out
<u>No show of oil, gas or water.</u>						

Describe in detail the manner in which the well was plugged, indicating where the mud fluid was placed and the method or methods used in introducing it into the hold. If cement or other plugs were used, state the character of same and depth placed, from _____ feet to _____ feet for each plug set.

Set bottom plug at 120'. Mixed and poured 15 sacks
cement thru drill pipe. Set top plug at 10' below
bottom of cellar. Mixed and poured 10 sacks cement.
2 Hours plugging hole.

1-22-1948

(If additional description is necessary, use BACK of this sheet)

Correspondence regarding this well should be addressed to Delta Production Co,
Address 523 Union Nat'l. Bank Bldg.,
Wichita, Kansas.

STATE OF Oklahoma, COUNTY OF Oklahoma, ss.
Victor E. Davis, (employee of owner) or (owner or operator) of the above-described well,

being first duly sworn on oath, says: That I have knowledge of the facts, statements, and matters herein contained and the log of the above-described well as filed and that the same are true and correct. So help me God.

(Signature) Transit Corporation, 3111 Apco Tower, Okla. City, Okla


By Victor E. Davis (Address) Asst. Sec'y.

SUBSCRIBED AND SWORN to before me this 16th day of January 1948

Maxine Chambers

Maxine Chambers Notary Public.

My commission expires 1-8-1952

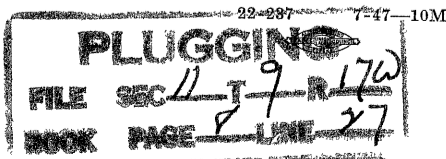

15-163-19247-00-00

DELTA PRODUCTION COMPANY

WESTHUSIN WELL NO. 1

0-NW/4 NW/4 NW/4

SEC. 11-9S-17W

ROCKS COUNTY, KANSAS

FORMATIONS	FROM	TO	
Clay & Rock	0	60	
Sand	60	68	
Shale & Shells	68	120	Ran 120' 8-5/8" Surface
Shale & Shells	120	490	Casing and Cemented w/100
Sand	490	565	Sks. Halliburton Bulk Cement.
Shale & Shells	465	1050	
Red Bed & Shale	1050	1285	
Anhydrite	1285	1320	
Shale & Shells	1320	1575	
Shale & Salt	1575	1680	
Shale & Shells	1680	1950	
Lime	1850	1890	
Lime & Shale	1890	2180	
Lime	2180	2225	
Shale & Lime	2225	2500	
Shale & Lime (Iron Pyrites)	2500	2540	
Shale & Lime	2540	2790	
Shale	2790	2853	
Shale & Lime	2853	2872	
Lime	2872	2930	
Lime & Shale	2930	3062	
Lime	3062	3077	
Cherty Lime	3077	3083	
Lime	3083	3095	
Lime & Shale	3095	3130	
Shale & Shells	3130	3149	
K. G. Lime	3149	3190	
Lime	3190	3385	
Lime & Shale	3385	3431	
Lime (Arbuckle)	3431	3466	
			3466

T.D. D. & A.

Contractor - Transit Corporation
3111 Apco Tower
Oklahoma City, Okla.

I hereby certify the foregoing to be a correct driller's log of the formations encountered in the above well.

PLUGGING
FILE SEC 11-9S-17W
BOOK PAGE 8 LINE 27

Victor E. Davis
Victor E. Davis
Assistant Secretary

Certified to before me this 21st day of January, 1948

1-22-1948

Maxine Chambers
Notary Public - Maxine Chambers

January 8, 1952
My Commission Expires